IREDELL COUNTY HEALTH DEPARTMENT

Statesville Office (704) 878-5305 Mooresville Office (704) 660-3625 PERMIT # 211063

IMPROVEMENT PERMIT / AUTHORIZATION TO CONSTRUCT / OPERATION PERMIT / EXISTING SYSTEM

PIN # 4777492423

APPLICANT: Chris Reeves APPLICANT ADDRESS: 108 Lady Bug Ct Statesville NC

SITE ADDRESS: 108 Ladybug Ct Statesville NC PHONE: 704-929-8663 ALT. PHONE: N/A


SITE DIRECTIONS: Jennings Rd T/L Trophy Dr T/L Lady Bug Ct First on right

SUBDIVISION: The reserve at deer Crossing SECTION: N/A LOT # 17 LOT AREA: 0.923 ac DESIGN FLOW: Ex L.T.A.R.: Ex


Septic Tank	Ex (gal)	STB	Date	☐ New System ☐ Repair ☐ Expansion System Type: I II III IV V VI	☒ Residence	No. Bedrooms	Ex	Water Supply	
Pump Tank	(gal)	PT	Date	System Description: Existing	☐ Business	No. Persons	Ex	☐ Private	
Pump Make	Model		Serial #	Repair System Description:	☐ Other	No. Employees		☒ Public	
# Nitrification Fields	Ex # Lines Ex		Linear Ft: Ex	Maintenance Agreement Required: ☐ YES ☒ NO	☐ Slab	☒ Crawl Space		☐ Community	
Trench Width	Ex Max. Trench Bottom Depth Ex		Gravel Depth N/A	☒ GRAVITY ☐ PRESSURE	☐ Basement w/plumbing			☐ Basement w/o plumbing	

Comments / Conditions: All building foundations must be 35' from any part of STS.

INITIAL SITE SKETCH

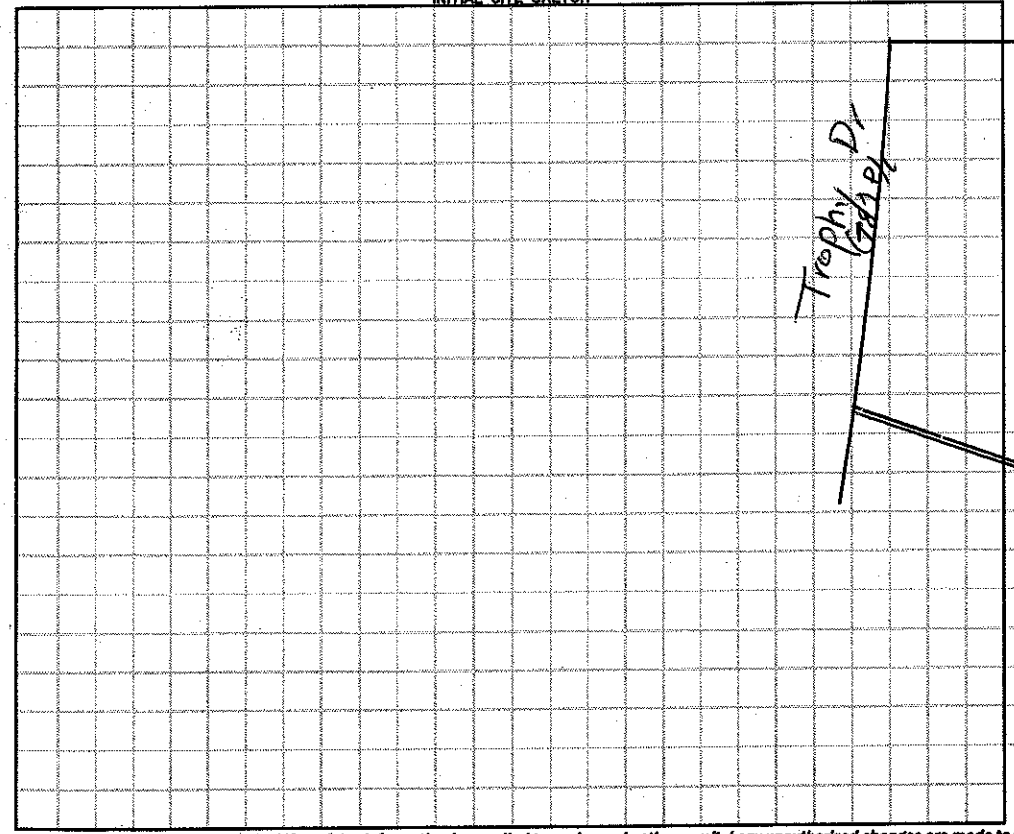

AS BUILT SKETCH

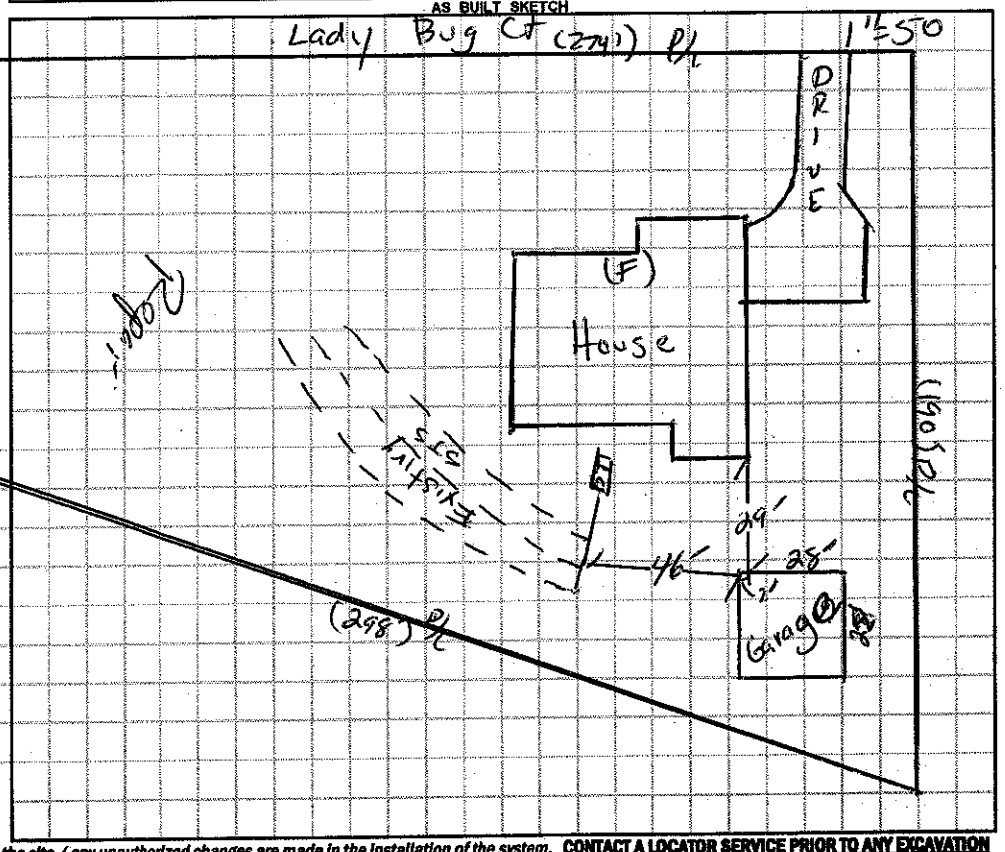

Permit can be suspended or revoked if any false information is supplied toward securing the permit / any unauthorized changes are made to the site / any unauthorized changes are made in the installation of the system. **CONTACT A LOCATOR SERVICE PRIOR TO ANY EXCAVATION**

☐ **IMPROVEMENT PERMIT** *with plat valid without expiration.* ☐ **IMPROVEMENT PERMIT** *with site plan valid for 60 mos.* ☐ **AUTHORIZATION TO CONSTRUCT** *valid for period equal to IMPROVEMENT PERMIT--not to exceed 60 mo.*

Owner / Applicant Signature: [signature] Date: 6/15/15 Installed by:

IMPROVEMENT PERMIT by: Date: OPERATION PERMIT by: Date:

AUTHORIZATION TO CONSTRUCT by: Date: Existing System Inspected by: [signature] Date: 06/17/15

Health Dept. Copy - WHITE Applicant (Final Approval) - YELLOW Applicant (Conditional Approval) - PINK