IREDELL COUNTY HEALTH DEPARTMENT

Statesville Office (704) 878-5305 Mooresville Office (704) 660-3625 PERMIT # 181677

IMPROVEMENT PERMIT / AUTHORIZATION TO CONSTRUCT / OPERATION PERMIT / EXISTING SYSTEM

PIN # 4747495117

APPLICANT: Dixieland Inc APPLICANT ADDRESS: 133 Redemption Rd.

SITE ADDRESS: 119 Ladybug Ct PHONE: 704-876-6162 ALT. PHONE: N/A

SITE DIRECTIONS: Hwy 21 N TL Jennings Rd TL Trophy Dr. TL Ladybug Ct


SUBDIVISION: The Reserve @ Deer Crossing SECTION: N/A LOT # 20 LOT AREA: .64acres DESIGN FLOW: 360gpd L.T.A.R.: 0.25

Septic Tank	1000 (gal)	STB	1012-1650	Date	11-16-13	☑ New System ☐ Repair ☐ Expansion	System Type: I II ☑ III IV V VI	☑ Residence	No. Bedrooms	3	Water Supply
Pump Tank	(gal)	PT		Date		System Description:	25% Reduction	☐ Business	No. Persons	6	☐ Private
Pump Make		Model		Serial #		Repair System Description:	Low Pressure PDBPS	☐ Other	No. Employees		☑ Public
# Nitrification Fields	1	# Lines	5	Linear Ft:	360	Maintenance Agreement Required:	☐ YES ☑ NO	☐ Slab	☑ Crawl Space		☐ Community
Trench Width	36"	Max. Trench Bottom Depth	36"	Gravel Depth	N/A		☑ GRAVITY ☐ PRESSURE	☐ Basement w/plumbing			☐ Basement w/o plumbing

Comments / Conditions: IMPROVEMENTS ONLY! Submit floor plan prior to issuance of CA! Install a 25% Reduction System on contour with serial distribution. Floor Plan faxed 11-1-13, CA

Issued.

INITIAL SITE SKETCH

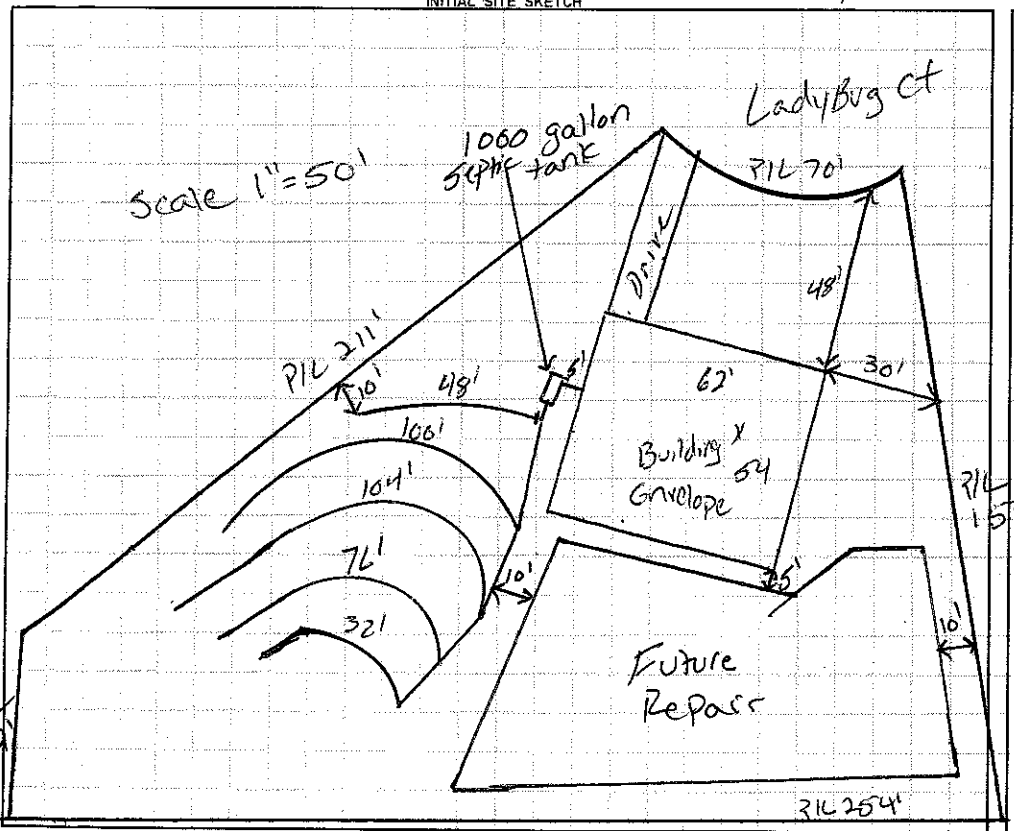

AS BUILT SKETCH

- Red Polylok filter installed
- Quick 4 Chambers installed
- Installed as drawn

Permit can be suspended or revoked if any false information is supplied toward securing the permit / any unauthorized changes are made to the site / any unauthorized changes are made in the installation of the system. **CONTACT A LOCATOR SERVICE PRIOR TO ANY EXCAVATION**

☐ **IMPROVEMENT PERMIT** *with plat valid without expiration.* ☑ **IMPROVEMENT PERMIT** *with site plan valid for 60 mos.* ☑ **AUTHORIZATION TO CONSTRUCT** *valid for period equal to IMPROVEMENT PERMIT--not to exceed 60 mo.*

Owner / Applicant Signature: Regina C Dardle Date: 11/21/13 Installed by: Steve Jordan

IMPROVEMENT PERMIT by: Justin Henderson Date: 11-1-13 OPERATION PERMIT by: Justin Henderson Date: 4-3-14

AUTHORIZATION TO CONSTRUCT by: Justin Henderson Date: 11-1-13 Existing System Inspected by: Date:

Health Dept. Copy - WHITE Applicant (Final Approval) - YELLOW Applicant (Conditional Approval) - PINK