IREDELL COUNTY HEALTH DEPARTMENT

STATESVILLE 704-878-5305 MOORESVILLE 704-664-5281

IMPROVEMENT PERMIT / AUTHORIZATION TO CONSTRUCT / OPERATION PERMIT / EXISTING SYSTEM INSPECTION

(3) (CI)

PERMIT# 140276 PIN# 4747398773 4747-49-5641 DATE 2-20-07

OWNER OR APPLICANT Dixieland Inc PHONE: Business 704 876-6162 Home 704 902 [redacted] 4971

ADDRESS Trophy Dr

LOCATION Jennings Rd North, (L) on Trophy Dr

SUBDIVISION Reserve at Deer Crossing BLOCK / SECTION LOT 24 LOT AREA .7426 SITE CLASS. PS DESIGN FLOW 48 L.T.A.R. .3

Septic Tank: 1000 Gallons; STB Date

Pump Tank: 1000 Gallons; PT Date

Pump Make: Model Serial No.

Nitrification Field: No Fields 1 Square Feet 1600 Linear Feet 400 total

No Lines 3 Trench Width 36" Max Trench Bottom Depth 36"

☒ New System ☐ Repair ☐ Expansion System Type: I II (III) IV V VI

System Description: Pump 25% Reduction

Repair System Description: LP 50% Reduction

Maintenance Agreement Required: ☐ Yes ☒ No

Gravel Depth " ☐ Gravity ☒ Pressure

☒ House/Mod. Home ☐ Mobile Home ☐ Business ☐ Other

No. Bedrooms 4 No. Persons No. Employees


Water Supply: ☒ Individual ☒ Public ☐ Community

☐ Slab ☐ Crawl Space ☐ Basement w/plumbing ☐ Basement wo/plumbing

Comments:/Conditions:

Comments:/Conditions:

INITIAL SITE SKETCH

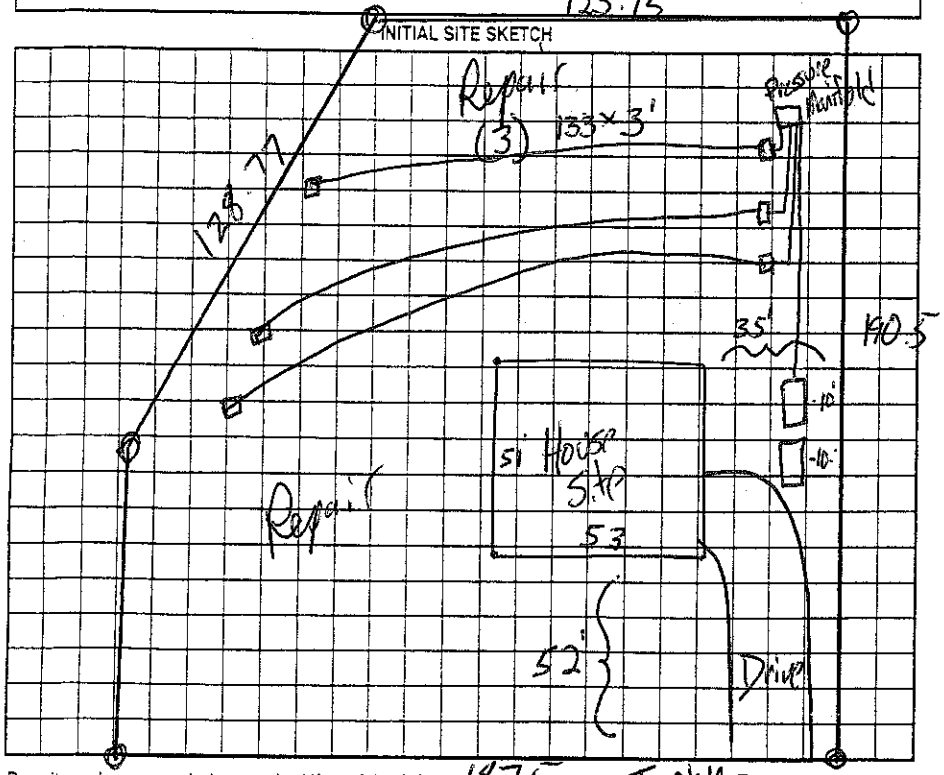

AS BUILT SKETCH

Permit can be suspended or revoked if any false information is supplied toward obtaining the permit/any unauthorized changes are made to the site/any unauthorized changes are made in the installation of the system. Improvement Permit with plat valid without expiration ☐ Improvement Permit with site plan valid for sixty months ☐ Authorization to Construct is valid for a period equal to that of Improvement Permit – not to exceed sixty months.

Signed: Regina C Daniels date 2-20-07

Improvement Permit by: James date 2-20-07

Authorization to Construct by: James date 2-20-07

Installed by: Rowan Sanitation

Operation Permit by: James date 10-2-07

Existing System Inspection by: date

HEALTH DEPT. COPY: WHITE OWNER COPY (FINAL): YELLOW OWNER COPY (INITIAL): PINK