IREDELL COUNTY HEALTH DEPARTMENT

Statesville Phone TR 3-7271 Mooresville Phone No. 664-5281

PERMIT TO INSTALL SEPTIC TANK

Permit No. 5 x 0 Permit Date 6-3 19 73

Owner Doyle White Address Statesville, NC.

Installed By Harlee Lackey Address Stony Point, NC


Location of Property 21 N. Left on Rd #1922 (Shoemaker Dr.) past Iredell Heights Devel. 1 mile - New Devel on Rt. before Creek.

Tank		Capacity		Length of Lines		Fixtures	
Block	( )	1000	(✓)	225'	(✓)	No. of Baths	(2)
Precast	(✓)	1250	( )	250'	( )	Dishwasher	( )
		1500	( )	Other		Garbage Grdr.	( )
		Other				Other	

NOTIFY HEALTH DEPARTMENT AT LEAST EIGHT HOURS BEFORE TANK IS TO BE INSPECTED.

Final Inspection 5-3 1973 Approved (✓) Disapproved ( )

Remarks No well on site at time of inspection

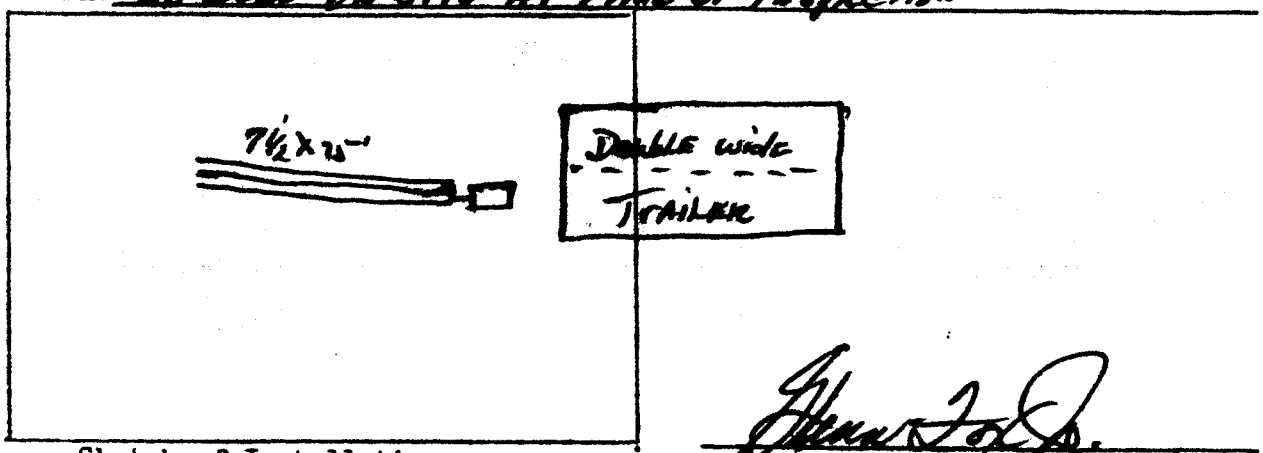

Sketch of Installation

Sanitarian