IREDELL COUNTY HEALTH DEPARTMENT

THIS PERMIT VOIDS PREVIOUS ISSUED 6/9/2003 (CI)

STATESVILLE 704-878-5305 MOORESVILLE 704-664-5281

IMPROVEMENT PERMIT / AUTHORIZATION TO CONSTRUCT / OPERATION PERMIT / EXISTING SYSTEM INSPECTION

PERMIT# 112612 PIN# 4747-52-0591 DATE 3-21-05

OWNER OR CONTRACTOR K.W. NICHOLSON INC PHONE: Business 704-902-0799 Home (704) 876-9040

ADDRESS 930 ARGYLE COURT, STATESVILLE, NC 28677

LOCATION US 21 N, TL WHITE'S FARM ROAD, TL DOE RUN LANE 1ST LOT ON LEFT

SUBDIVISION GRAYSTONE MEADOWS BLOCK / SECTION I LOT 1 LOT AREA 1.186 ACRES SITE CLASS. PS DESIGN FLOW 360 L.T.A.R. 0.25 GPD/FT²

Septic Tank: 1000 Gallons; STB 1012 Date 2-17-05
Pump Tank: ____ Gallons; PT ____ Date ____
Pump Make: ____ Model ____ Serial No. 360
Nitrification Field: No Fields 1 Square Feet 1440 Linear Feet ~~480~~
No Lines FOUR Trench Width 36" Max Trench Bottom Depth 30" Gravel Depth 12"

☑ New System ☐ Repair System Type I (II) III, IV, V, VI (258)
System Description: ~~CONVENTIONAL~~, GRAVITY
Repair System Description: 50% REDUCTION LOW PRESSURE
Maintenance Agreement Required: ☐ Yes ☑ ~~No~~


☑ House/Mod. Home No. Bedrooms 3
☐ Mobile Home No. Bathrooms ____
☐ Business No. Employees ____
☐ Other ____
☐ Slab ☐ Crawl Space ☑ Basement w/plumbing ☐ Basement wo/plumbing

Water Supply: ☐ Individual ☑ Public ☐ Community

Comments:/Conditions:

Comments:/Conditions: SEPTIC TANK WITH MARKER INSTALLED USING "TUFTITE" FILTER

INITIAL SITE SKETCH

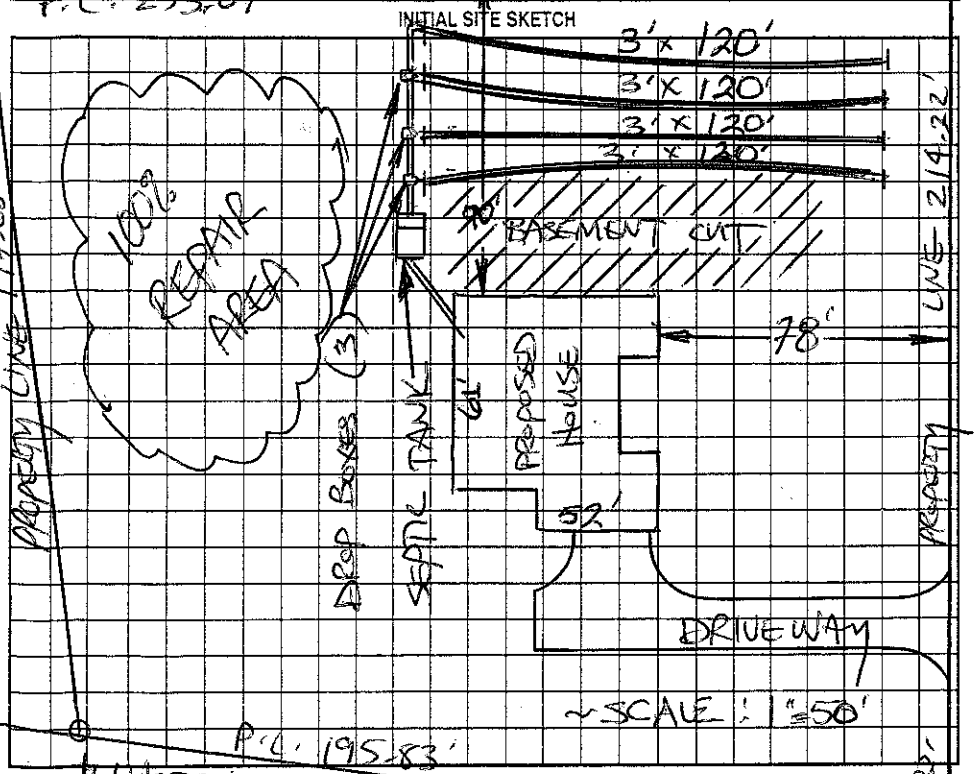

AS BUILT SKETCH

SYSTEM INSTALLED ACCORDING TO INITIAL SITE SKETCH USING 92 "QUICK-4" INFILTRATOR CHAMBERS AS "ACCEPTED" SYSTEM

Permit can be suspended or revoked if any false information is supplied toward securing the permit/any unauthorized changes are made to the site/any unauthorized changes are made in the installation of the system. Improvement Permit with plat valid without expiration. Improvement Permit with site plan valid for sixty months. Authorization to Construct is valid for a period equal to that of Improvement Permit – not to exceed sixty months.

Signed: [signature] date 3-21-05 Installed by: DAVID YOUNTZ

Improvement Permit by: STEVE HENDRICK date 3-21-05 Operation Permit by: STEVE HENDRICK date 8-29-05

Authorization to Construct by: STEVE HENDRICK date 3-21-05 Existing System Inspection by: ____ date ____

HEALTH DEPT. COPY: WHITE OWNER COPY (FINAL): YELLOW OWNER COPY (INITIAL): PINK