Permit: Voids IP issued 7/16/99

IREDELL COUNTY HEALTH DEPARTMENT

STATESVILLE 704-878-5305 MOORESVILLE 704-664-5281

IMPROVEMENT PERMIT / AUTHORIZATION TO CONSTRUCT / OPERATION PERMIT / EXISTING SYSTEM INSPECTION

PERMIT# 079779 PIN# 4744549142 (pt) DATE 7/20/01

OWNER OR CONTRACTOR Mike Gaither PHONE: Business (704) 871-7295 Home

ADDRESS 300 Marshall Farm Rd Harmony, NC 28634

LOCATION 21 N. to Shoemaker Road, Continue on Whites Farm Rd, to Saddlewood Lane on Rt.

SUBDIVISION Saddlewood BLOCK / SECTION I LOT 20 LOT AREA 125x190' SITE CLASS PS DESIGN FLOW 360 L.T.A.R. .4

Septic Tank: 1,000 Gallons: STB 1012 Date 8-2-01
Pump Tank: Gallons: PT Date
Pump Make: Model Serial No
Nitrification Field: No Fields 1 Square Feet 900 Linear Feet 300'
No Lines 5 Trench Width 36" Max Trench Bottom Depth 36" Gravel Depth 12"

X New System ☐ Repair System Type: I (II, III, IV, V, VI)
System Description: Gravity, Conventional
Repair System Description: Gravity, 50% Reduction
Maintenance Agreement Required: ☐ Yes X No

X House/Mod. Home ☐ Mobile Home ☐ Business ☐ Other
No. Bedrooms 3 No. Bathrooms 2 No. Employees


Water Supply: ☐ Individual ☐ Public ☐ Community

☐ Slab ☐ Crawl Space ☐ Basement w/plumbing X Basement wo/plumbing


Comments:/Conditions: ① Install lines on contour using drop boxes ② Maintain 10ft setback from PL & 5' from crawl space and 15' from basement with septic system

Comments:/Conditions. -Septic Tank Must be Installed -Poly Lok Filter Installed

INITIAL SITE SKETCH 1" = 40'

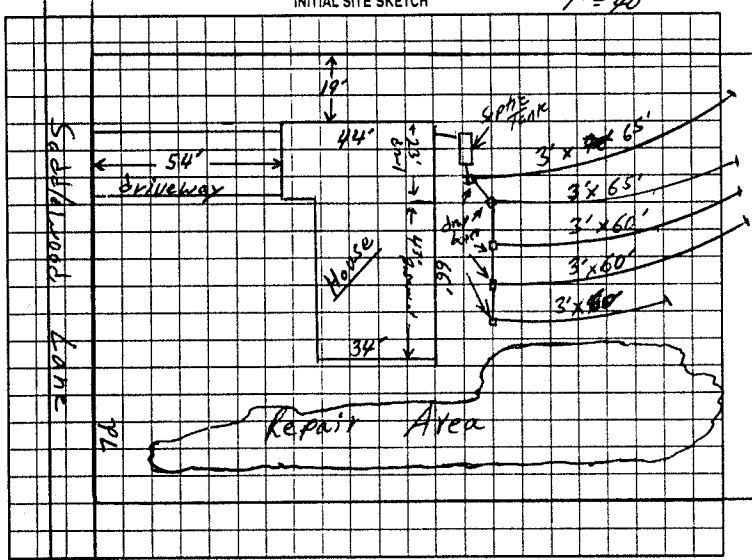

AS BUILT SKETCH

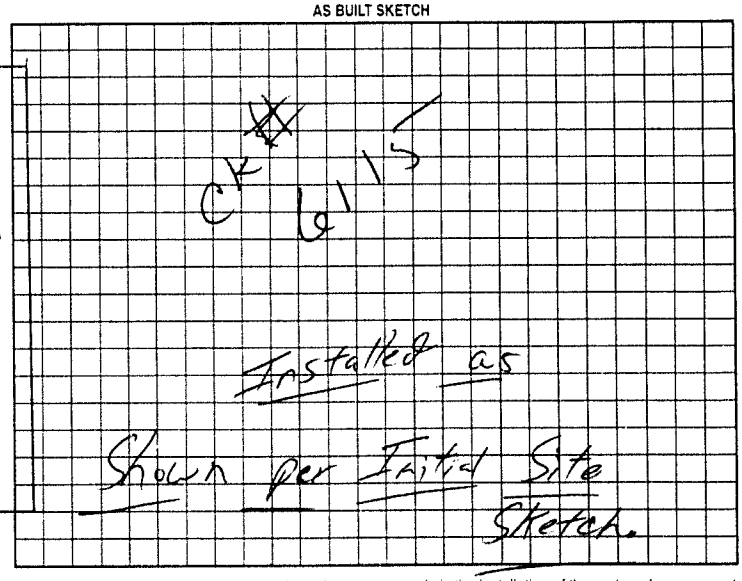

Permit can be suspended or revoked if any false information is supplied toward securing the permit/any unauthorized changes are made to the site/any unauthorized changes are made in the installation of the system. Improvement Permit with plat valid without expiration. Improvement Permit with site plan valid for sixty months. Authorization to Construct is valid for a period equal to that of Improvement Permit – not to exceed sixty months.

Signed: Ronald E. Smith date 7/27/01 Installed by: A-1 Backhoe

Improvement Permit by: William O. Johnson date 7/20/01 Operation Permit by: William O. Johnson date 10/24/01

Authorization to Construct by: William O. Johnson date 7/20/01 Existing System Inspection by: date

HEALTH DEPT COPY WHITE OWNER COPY (FINAL) YELLOW OWNER COPY (INITIAL) PINK