IREDELL COUNTY HEALTH DEPARTMENT

STATESVILLE 704-878-5305 MOORESVILLE 704-664-5281

IMPROVEMENT PERMIT / AUTHORIZATION TO CONSTRUCT / OPERATION PERMIT / EXISTING SYSTEM INSPECTION

PERMIT# 095506 PIN# 4747631628 DATE 4/24/01

OWNER OR CONTRACTOR Johns Welding PHONE: Business (704) 880-6603 Home (704) 872-7885

ADDRESS 1516 Mocksville Hwy Statesville NC 28625

LOCATION Hwy 21 N @ Shumaker, Rt Whites Farm (R) Saddlewood, (R) appaloosa Lot in R #39

SUBDIVISION Saddlewood BLOCK / SECTION #2 LOT 39 LOT AREA .53 SITE CLASS 75 DESIGN FLOW 360 L.T.A.R. .35

Septic Tank: 4,000 Gallons. STB 10-12 Date 12-20-00
Pump Tank: Gallons; PT Date
Pump Make: Model Serial No
Nitrification Field: No Fields 1 Square Feet 1029 Linear Feet 350'
No Lines 3 Trench Width 36 Max Trench Bottom Depth 30" Gravel Depth 12"

X New System ☐ Repair System Type: I (II) III, IV, V, VI
System Description: Gravity, Conventional
Repair System Description: Pump, 25% Reduction
Maintenance Agreement Required: ☐ Yes X No
☐ Slab X Crawl Space ☐ Basement w/plumbing ☐ Basement wo/plumbing


X House/Mod. Home No. Bedrooms 3
☐ Mobile Home No. Bathrooms 2
☐ Business No. Employees
☐ Other

Water Supply: ☐ Individual X Public ☐ Community

Comments/Conditions: ① Install liner on contour ② Keep lines 10ft from Property Liner

Comments/Conditions: - Polylok Filter Installed
- Septic Tank Marker Installed

INITIAL SITE SKETCH

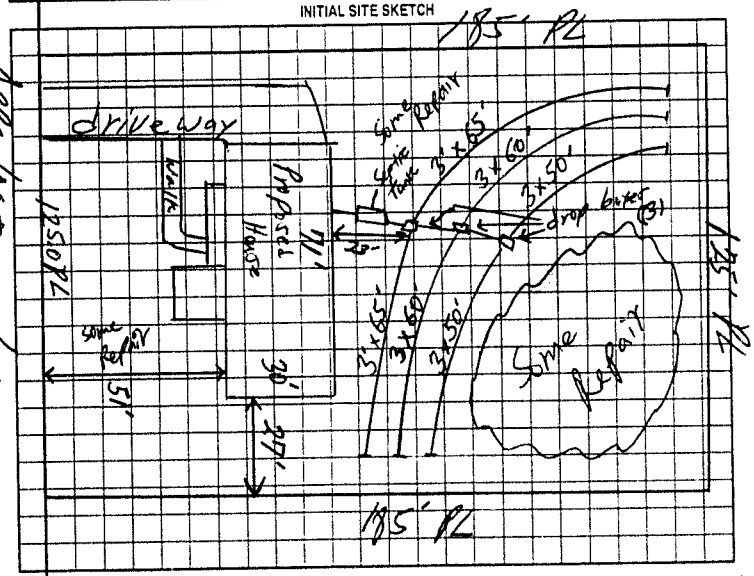

AS BUILT SKETCH

Installed as Shown Per Initial Site Sketch

Permit can be suspended or revoked if any false information is supplied toward securing the permit/any unauthorized changes are made to the site/any unauthorized changes are made in the installation of the system. Improvement Permit with plat valid without expiration. Improvement Permit with site plan valid for sixty months. Authorization to Construct is valid for a period equal to that of Improvement Permit – not to exceed sixty months.

Signed: _____ date 4/25/01 Installed by: Steve Jordan

Improvement Permit by: William O. Johnson RSI date 4/24/01 Operation Permit by: William O. Johnson date 4/16/02

Authorization to Construct by: William O. Johnson RSI date 4/24/01 Existing System Inspection by: _____ date _____

HEALTH DEPT COPY WHITE OWNER COPY (FINAL) YELLOW OWNER COPY (INITIAL) PINK

Appaloosa Lane