IREDELL COUNTY HEALTH DEPARTMENT

STATESVILLE 704-878-5305 MOORESVILLE 704-664-5281

IMPROVEMENT PERMIT / AUTHORIZATION TO CONSTRUCT / OPERATION PERMIT / EXISTING SYSTEM INSPECTION

PERMIT# 093071 PIN# 4747 63 1628 DATE 11-30-00

OWNER OR CONTRACTOR CCS INC PHONE: Business 929-8635 Home

ADDRESS 130 DOBBS DR, STATESVILLE NC 28625

LOCATION US 21 N, TL WHITES FARM RD, TR SADDLEWOOD LN, TR APPALOOSA LN, 3RD LOT ON LEFT

SUBDIVISION SADDLEWOOD BLOCK / SECTION II LOT 26 LOT AREA 0.573 ACRE SITE CLASS PS DESIGN FLOW 360 L.T.A.R. 0.30 GPD/FT²

Septic Tank: 1000 Gallons: STB 372 Date 10-28-00
Pump Tank: Gallons: PT Date
Pump Make: Model Serial No.
Nitrification Field: No. Fields 1 Square Feet EQ. TO 1200 Linear Feet 200
No. Lines SIX Trench Width 24" Max. Trench Bottom Depth 36" Depth SAND 6"

☑ New System ☐ Repair System Type: I, II, (III), IV, V, VI
System Description: 50% REDUCTION GRAVITY
Repair System Description: 50% REDUCTION PUMP
Maintenance Agreement Required: ☐ Yes ☑ No

☑ House/Mod. Home ☐ Mobile Home ☐ Business ☐ Other
No. Bedrooms 3 No. Bathrooms 2½ No. Employees


Water Supply: ☐ Individual ☑ Public ☐ Community

☐ Slab ☑ Crawl Space ☐ Basement w/plumbing ☐ Basement wo/plumbing

Comments/Conditions: ① KEEP SYSTEM MINIMUM TEN (10) FEET FROM WATER LINE ② USE FORM-TWO (42) PPBPS PANELS IN SIX (6) EQUAL LENGTH LINES ③ USE ONE FLOW DIVIDER TEE TO ACHIEVE EQUAL DISTRIBUTION INTO TWO SETS OF DISTRIBUTION BOXES.

Comments/Conditions: ④ KEEP ALL CONSTRUCTION TRAFFIC OFF OF SYSTEM AREA.

INITIAL SITE SKETCH SCALE: 1"=40'

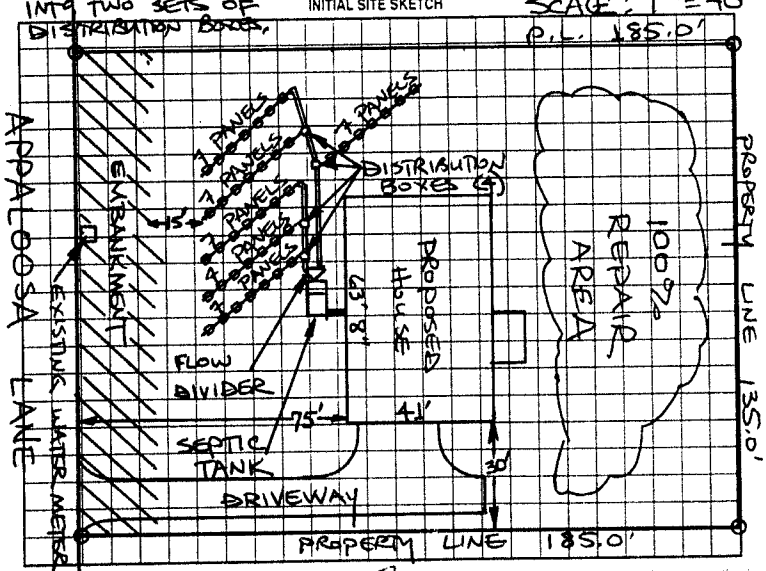

AS BUILT SKETCH

INSTALLED AS SHOWN WITH PICTURE FILTER MASTER

Permit can be suspended or revoked if any false information is supplied toward securing the permit/any unauthorized changes are made to the site/any unauthorized changes are made in the installation of the system. Improvement Permit with plat valid without expiration. Improvement Permit with site plan valid for sixty months. Authorization to Construct is valid for a period equal to that of Improvement Permit – not to exceed sixty months.

Signed: [signature] date 12/15/00 Installed by: THOMPSON BACKHOE

Improvement Permit by: STEVE HEDRICK date 11-30-00 Operation Permit by: [signature] PSI date 2-22-01

Authorization to Construct by: STEVE HEDRICK date 11-30-00 Existing System Inspection by: date

HEALTH DEPT. COPY WHITE OWNER COPY (FINAL) YELLOW OWNER COPY (INITIAL) PINK