This permit voids previously issued permit dated 7/13/99

IREDELL COUNTY HEALTH DEPARTMENT

STATESVILLE 704-878-5305 (C) MOORESVILLE 704-664-5281

IMPROVEMENT PERMIT / AUTHORIZATION TO CONSTRUCT / OPERATION PERMIT / EXISTING SYSTEM INSPECTION

PERMIT# 079999124491 PIN# 4747539998 DATE 7-13-04

OWNER OR CONTRACTOR R+L Constructors LLC PHONE: Business (704) 880-8219 Home (704) 881-0071

ADDRESS 120 White Dogwood Lane, Statesville, N.C. 28625

LOCATION 21 N. (C) Shumaker Rd to White Farm Rd, (R) Saddlewood Lane, Lot #18 on (R)

SUBDIVISION Saddlewood BLOCK / SECTION — LOT 18 LOT AREA 125'x190' SITE CLASS. PS DESIGN FLOW 480 L.T.A.R. .30 gpd

Septic Tank: 1,000 Gallons; STB 1012 Date 6-27-04
Pump Tank: _____ Gallons; PT _____ Date _____
Pump Make: _____ Model _____ Serial No. _____
Nitrification Field: No Fields 1 Square Feet Eq to/600 Linear Feet 400
No Lines 6 Trench Width 36 Max Trench Bottom Depth 36" Gravel Depth N/A

☒ New System ☐ Repair System Type: I, II, III, IV, V, VI
System Description: Gravity, 25% Reduction
Repair System Description: Pump – LP Panels
Maintenance Agreement Required: ☐ Yes ☐ No

☒ House/Mod. Home ☐ Mobile Home ☐ Business ☐ Other
No. Bedrooms 4 No. Bathrooms 3 No. Employees _____


☒ Slab ☒ Crawl Space ☐ Basement w/plumbing ☐ Basement wo/plumbing

Water Supply: ☒ Individual ☒ Public ☐ Community

Comments:/Conditions:

Comments:/Conditions: SEPTIC TANK WITH MARKER INSTALLED USING "TUFTITE" FILTER

INITIAL SITE SKETCH 1"=50'

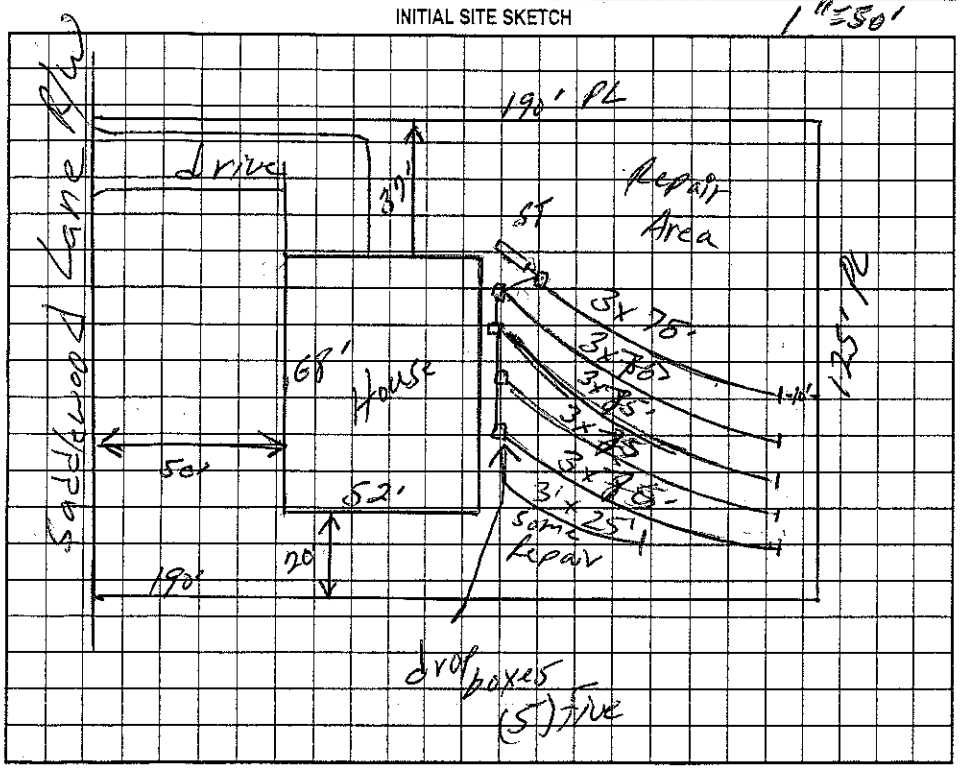

AS BUILT SKETCH

SYSTEM INSTALLED ACCORDING TO INITAL SITE SKETCH

Permit can be suspended or revoked if any false information is supplied toward securing the permit/any unauthorized changes are made to the site/any unauthorized changes are made in the installation of the system. Improvement Permit with plat valid without expiration. Improvement Permit with site plan valid for sixty months. Authorization to Construct is valid for a period equal to that of Improvement Permit – not to exceed sixty months.

Signed: Randy W. L date 7/13/04 Installed by: Piedmont Backhoe

Improvement Permit by: [signature] date 7/13/04 Operation Permit by: Steve Hedrick date 1-3-05

Authorization to Construct by: [signature] date 7/13/04 Existing System Inspection by: _____ date _____

HEALTH DEPT. COPY: WHITE OWNER COPY (FINAL): YELLOW OWNER COPY (INITIAL): PINK