IREDELL COUNTY HEALTH DEPARTMENT

STATESVILLE 704-878-5305 MOORESVILLE 704-664-5281

IMPROVEMENT PERMIT / AUTHORIZATION TO CONSTRUCT / OPERATION PERMIT / EXISTING SYSTEM INSPECTION

PERMIT# 79758 PIN# 4747549142 DATE 10-28-99

OWNER OR CONTRACTOR Randy Trivette PHONE: Business 872-7707 Home

ADDRESS Whites Fm Rd

LOCATION 21N TL Jennings Rd TL White's Fm Rd on left

SUBDIVISION Saddlebrook BLOCK / SECTION LOT 1 LOT AREA 1.88 acres SITE CLASS. PS DESIGN FLOW 360 L.T.A.R. .3

Septic Tank: 1000 Gallons; ST# 1012 Date 11-20-99

Pump Tank: Gallons; PT Date

Pump Make: Model Serial No.

Nitrification Field: No Fields 1 Square Feet 1200 Linear Feet 400

No Lines 3 Trench Width 36" Max Trench Bottom Depth 36" Gravel Depth 12"

☑ New System ☐ Repair System Type: I, II, III, IV, V, VI

System Description: Conv. Gravity

Repair System Description: 25% Reduction

Maintenance Agreement Required: ☐ Yes ☑ No

☑ House/Mod. Home No. Bedrooms 3

☐ Mobile Home No. Bathrooms 2

☐ Business No. Employees

☐ Other


☐ Slab ☐ Crawl Space ☐ Basement w/plumbing ☑ Basement wo/plumbing

Water Supply: ☐ Individual ☑ Public ☐ Community

Comments/Conditions: Replacement permit issued June 11, 1999

Comments/Conditions:

INITIAL SITE SKETCH

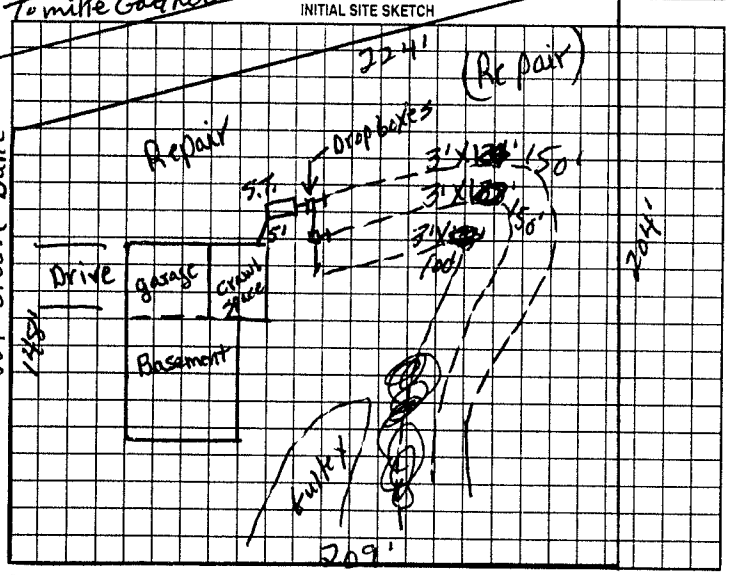

AS BUILT SKETCH

Same as initial sketch except lengths of lines

Permit can be suspended or revoked if any false information is supplied toward securing the permit/any unauthorized changes are made to the site/any unauthorized changes are made in the installation of the system. Improvement Permit with plat valid without expiration. Improvement Permit with site plan valid for sixty months. Authorization to Construct is valid for a period equal to that of Improvement Permit – not to exceed sixty months.

Signed: [signature] date 2-16-00 Installed by: Knox Fantscaping

Improvement Permit by: P.C. Moore date 10-28-99 Operation Permit by: P.C. Moore date 2-25-00

Authorization to Construct by: P.C. Moore date 10-28-99 Existing System Inspection by: date

HEALTH DEPT. COPY: WHITE OWNER COPY (FINAL): YELLOW OWNER COPY (INITIAL): PINK