IREDELL COUNTY HEALTH DEPARTMENT - *ENVIRONMENTAL HEALTH* ☑ STATESVILLE OFFICE 704-878-5305 ☐ MOORESVILLE OFFICE 704-664-5281

IMPROVEMENT PERMIT / AUTHORIZATION TO CONSTRUCT / OPERATION PERMIT / EXISTING SYSTEM INSPECTION

PERMIT # 165074 PIN # 4747-54-4762 DATE APRIL 1 2011

OWNER TERRANCE MARK HAMBY PHONE: Home/Cell # 704-682-4419 Business # 704-876-2654

SITE ADDRESS 228 DONSDALE DRIVE OWNER / APPLICANT ADDRESS 252 MAPLE CREEK DR.

SITE DIRECTIONS US 21 NORTH, TL JENNINGS ROAD, TL WHITE'S FARM RD, TL DONSDALE DR LOT ON RIGHT

SUBDIVISION DONSDALE BLOCK / SECTION II LOT # 70' LOT AREA 0.937 ACRE DESIGN FLOW 360 L.T.A.R. 0.25 AN/RTR

Septic Tank 1000 Gallons: STB 1012 Date 3-18-11

Pump Tank ____ Gallons: P T ____ Date ____

Pump Make ____ Model ____ Serial # ____

No. Nitrification Fields: 1 No. Lines 4 Linear Feet ____

Trench Width 36" Max. Trench Bottom Depth 36" Gravel Depth N/A

☑ New System ☐ Repair ☐ Expansion System Type I II (III) IV V VI

System Description: 25% REDUCTION GRAVITY

Repair System Description: 25% RED. SHALLOW PLACED

Maintenance Agreement Required ☐ YES ☑ NO

☑ GRAVITY ☐ PRESSURE

☑ Residence No. Bedrooms 3 ☐ Business No. Persons ____ ☐ Other No. Employees ____

☐ Slab ☐ Crawl Space ☑ Basement w/plumbing ☐ Basement w/o plumbing


Water Supply: ☐ Private ☑ Public ☐ Community

Comments / Conditions: REMOVE EXISTING FILL DIRT PRIOR TO ISSUANCE of AUTHORIZATION TO CONSTRUCT


Polylock filter.

ST mark.

INITIAL SITE SKETCH

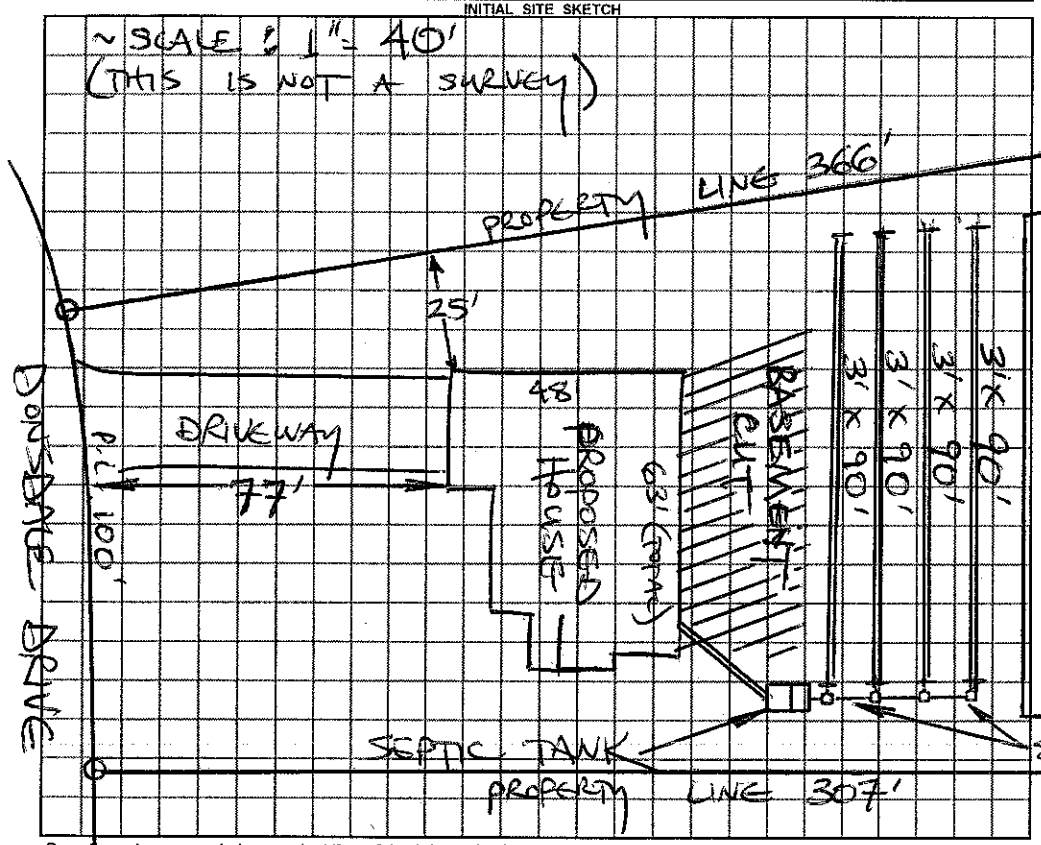

AS BUILT SKETCH

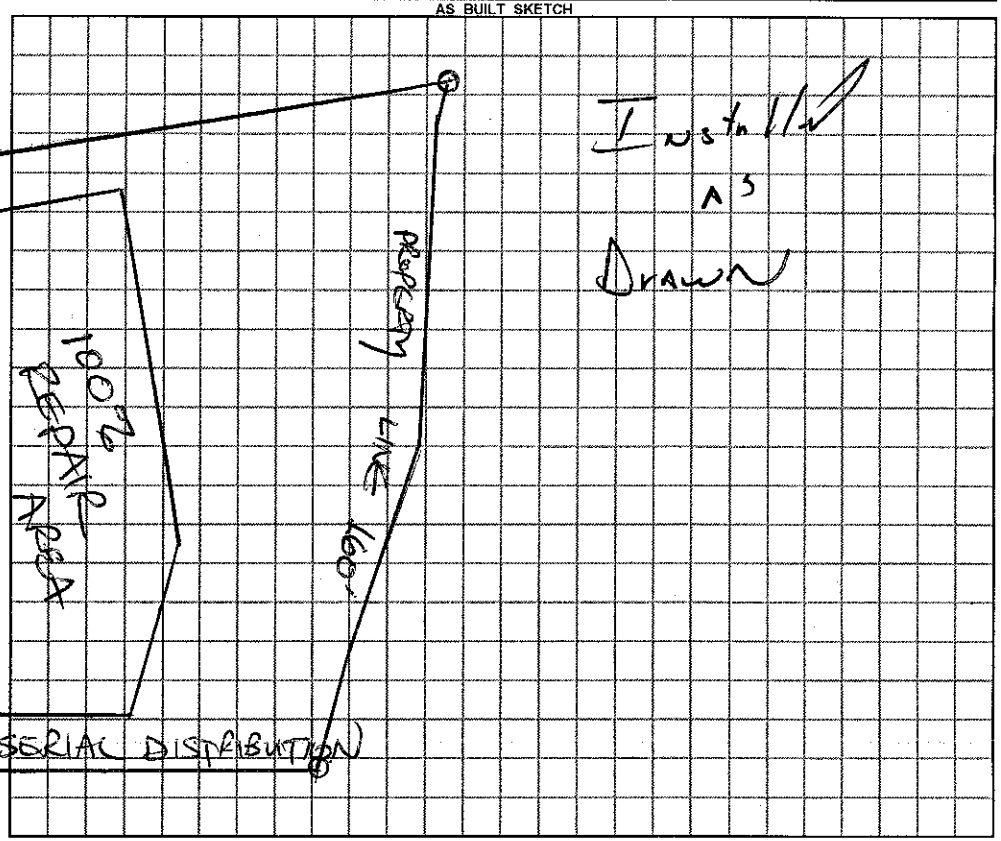

Permit can be suspended or revoked if any false information is supplied toward securing the permit / any unauthorized changes are made to the site / any unauthorized changes are made in the installation of the system.

☐ ***IMPROVEMENT PERMIT*** with plat valid without expiration ☐ ***IMPROVEMENT PERMIT*** with ~~plat valid without expiration~~ site plan valid 60 mo. ☐ ***AUTHORIZATION TO CONSTRUCT*** valid for period equal to IMPROVEMENT PERMIT--not to exceed 60 mo.

Owner / Applicant Signature: [signature] Date 4/1/11 Installed by: [signature]

IMPROVEMENT PERMIT by: STEVE HEDRICK REHS Date 4/1/2011 OPERATION PERMIT by: [signature] REHS Date 4 JAN. 12

AUTHORIZATION TO CONSTRUCT by: STEVE HEDRICK REHS Date 4/11/2011 Existing System Inspected by: ____ REHS Date ____

YOU SHOULD CONTACT A LOCATOR SERVICE PRIOR TO ANY EXCAVATION

White Copy -- Environmental Health YELLOW COPY (Final) Owner / Applicant PINK COPY (Initial) Owner / Applicant