# IREDELL COUNTY HEALTH DEPARTMENT

## IMPROVEMENT PERMIT / AUTHORIZATION TO CONSTRUCT / OPERATION PERMIT / EXISTING

STATESVILLE 704-878-5305 (CI) MOORESVILL

PERMIT# 143829 PIN# 4747545581

OWNER OR APPLICANT Builtrite Construction PHONE: Business 704 876 1955 Home

ADDRESS 295 Treebark Road

LOCATION Highway 21 N - left on Ramsdale Dr. - Property on (R)

SUBDIVISION Ramsdale BLOCK / SECTION 2 LOT 72 LOT AREA .858 SITE CLASS. R5 DESIGN FLOW 360

Septic Tank: 1000 Gallons; STB 8-27-07 Date 760

Pump Tank: Gallons; PT Date

Pump Make: Model Serial No.

Nitrification Field: No Fields 1 Square Feet 1200 Linear Feet 300

No Lines 3 Trench Width 36" Max Trench Bottom Depth 36" Gravel Depth

☒ New System ☐ Repair ☐ Expansion System Type: I II III IV V VI

System Description: 25% Reduction Gravity

Repair System Description: 25% Reduction Gravity

Maintenance Agreement Required: ☐ Yes ☐ No

☒ Gravity ☐ Pressure ☐ Slab ☒ Crawl Space ☐ Basement


☒ House/Mod. Home ☐ Mobile Home ☐ Business ☐ Other

Comments:/Conditions:


Comments:/Conditions:

Black/Red Filter

INITIAL SITE SKETCH

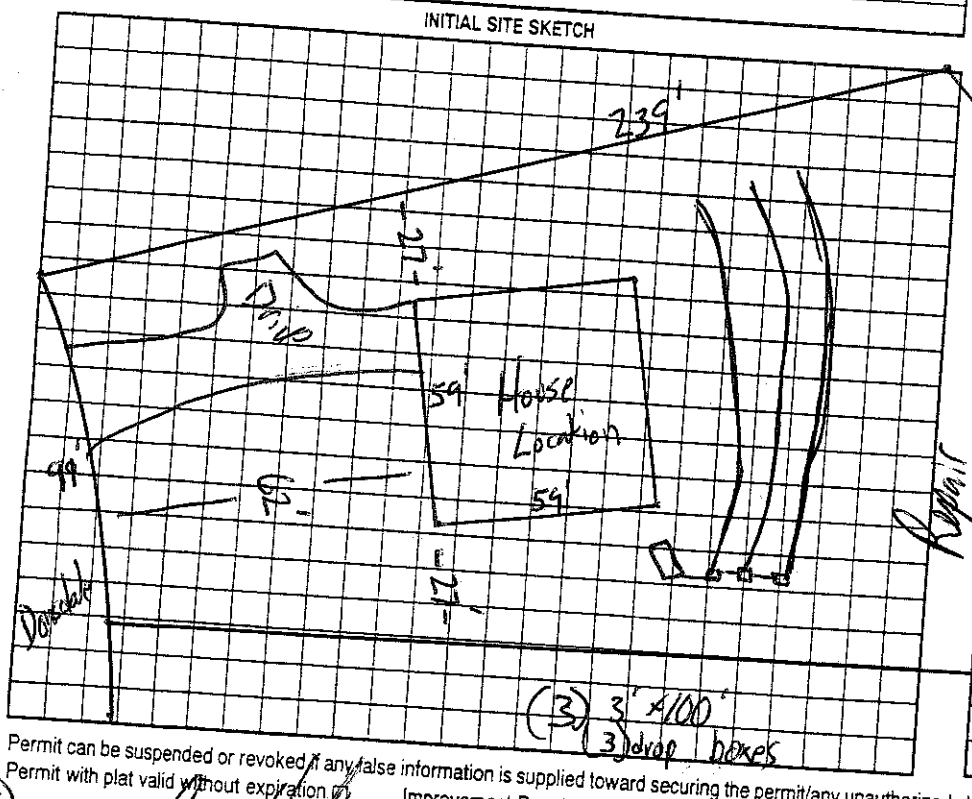


AS BUILT SKETCH

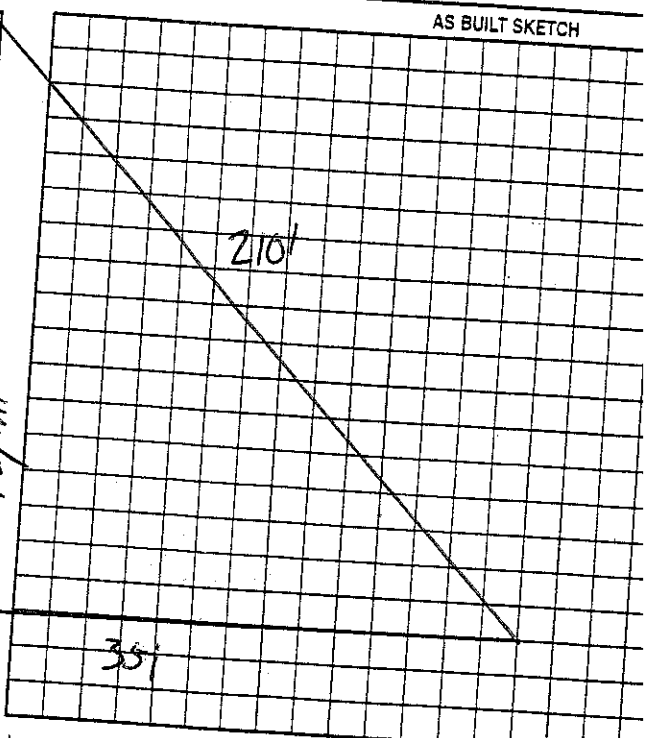


Permit can be suspended or revoked if any false information is supplied toward securing the permit/any unauthorized changes are made to the site/any unauthorized changes are made in the installa

Permit with plat valid without expiration ☐ Improvement Permit with site plan valid for sixty months ☒ Authorization to Construct is valid for a period equal to that of Improvement Perr

Signed:

Improvement Permit by: date 8-14-07 Installed by: Madison Grading

Authorization to Construct by: date 8-14-07 Operation Permit by:

date 8-14-07 Existing System Inspection by:

HEALTH DEPT. COPY: WHITE OWNER COPY (FINAL): YELLOW OWNER COPY (INITIAL): PINK

# IREDELL COUNTY HEALTH DEPARTMENT

STATESVILLE 704-878-5305 (CI) MOORESVILLE 704-664-5281

## IMPROVEMENT PERMIT / AUTHORIZATION TO CONSTRUCT / OPERATION PERMIT / EXISTING SYSTEM INSPECTION

PERMIT# 143829 PIN# 4747545581 DATE 8-14-07

OWNER OR APPLICANT Builtrite Construction PHONE: Business 704 876 1955 Home

ADDRESS 295 Treebark Road

LOCATION Highway 21 N - left on Donsdale Dr. - Property on (R)

SUBDIVISION Donsdale BLOCK / SECTION 2 LOT 72 LOT AREA .858 SITE CLASS. RS DESIGN FLOW 360 L.T.A.R. .3

Septic Tank: 1000 Gallons; STB 8-27-07 Date 760
Pump Tank: Gallons; PT Date
Pump Make: Model Serial No.
Nitrification Field: No Fields 1 Square Feet 1200 Linear Feet 300
No Lines 3 Trench Width 36" Max Trench Bottom Depth 36"

☒ New System ☐ Repair ☐ Expansion System Type: I / II / III / IV / V / VI (II)
System Description: 25% Reduction Gravity
Repair System Description: 25% Reduction Gravity
Maintenance Agreement Required: ☐ Yes ☐ No
Gravel Depth ☒ Gravity ☐ Pressure

☒ House/Mod. Home No. Bedrooms 3
☐ Mobile Home No. Persons
☐ Business No. Employees
☐ Other


Water Supply: ☐ Individual ☒ Public ☐ Community

☐ Slab ☒ Crawl Space ☐ Basement w/plumbing ☐ Basement wo/plumbing


Comments:/Conditions:

Comments:/Conditions:
Black/Red Filter

INITIAL SITE SKETCH

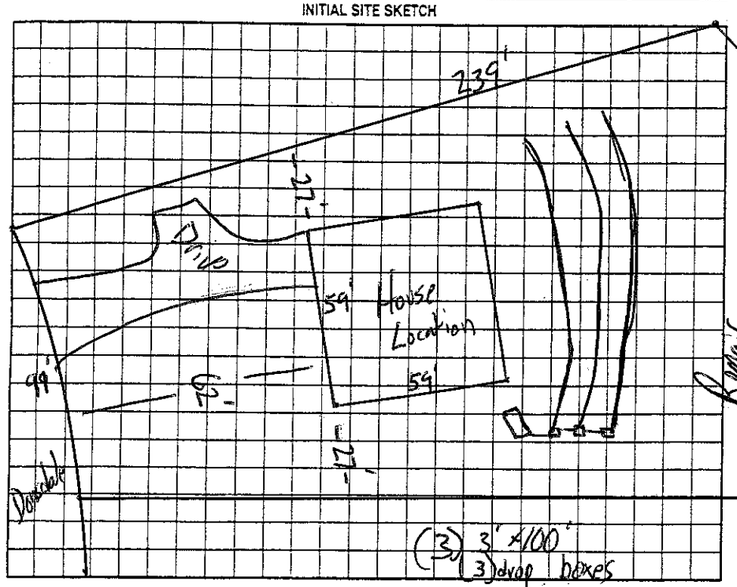


AS BUILT SKETCH

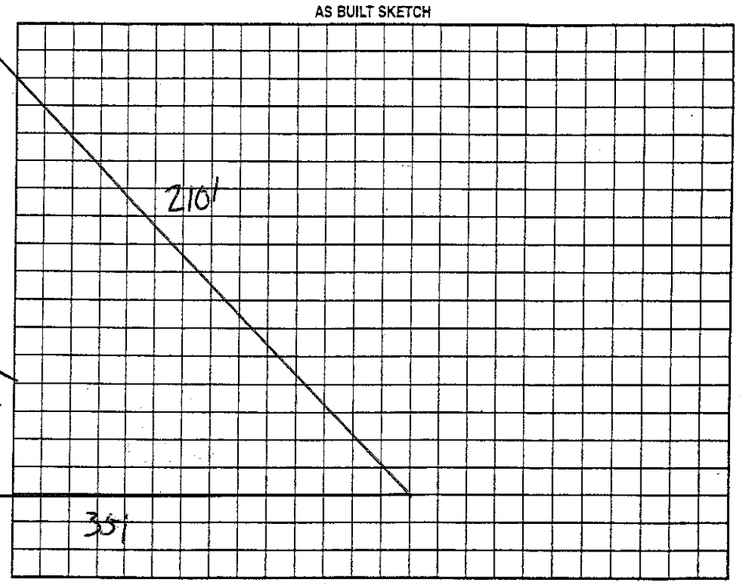


Permit can be suspended or revoked if any false information is supplied toward securing the permit/any unauthorized changes are made to the site/any unauthorized changes are made in the installation of the system. Improvement Permit with plat valid without expiration if Improvement Permit with site plan valid for sixty months. Authorization to Construct is valid for a period equal to that of Improvement Permit – not to exceed sixty months.

Signed: date 8-14-07
Improvement Permit by: date 8-14-07
Authorization to Construct by: date 8-14-07

Installed by: Madison Grading
Operation Permit by: date 12-19-07
Existing System Inspection by: date

HEALTH DEPT. COPY: WHITE OWNER COPY (FINAL): YELLOW OWNER COPY (INITIAL): PINK