4:00 - 4:30

C#

Anytime

IREDELL COUNTY HEALTH DEPARTMENT

STATESVILLE 704-878-5305 MOORESVILLE 704-664-5281

IMPROVEMENT PERMIT / AUTHORIZATION TO CONSTRUCT / OPERATION PERMIT / EXISTING SYSTEM INSPECTION

PERMIT# 138765 PIN# 4747-54-7832 DATE 10/27/06

OWNER OR APPLICANT LEE HOOTS PHONE: Business 704-929-9322 Home 704-539-4862

ADDRESS 385 BASSETT RD. OLEN, NC 28660

LOCATION HWY 21 NORTH (L) HUMMER DR., (R) DONSDALE DR., LOT ON LEFT ON CORNER OF STALLION & DONSDALE DR.

SUBDIVISION DONSDALE BLOCK / SECTION II LOT 26 LOT AREA 0.587 AC. SITE CLASS. PS DESIGN FLOW 360 GPD L.T.A.R. 0.30 GPD/FT²

Septic Tank: 1,000 Gallons: STB 760 Date 10-27-06

Pump Tank: 1,000 Gallons: PT 362 Date 8-25-06

Pump Make: ZOELLER Model BM 152-0005 Serial No.

Nitrification Field: No Fields 1 Square Feet EQ to 1200 Linear Feet 300'

No Lines 3 @ 100' Trench Width 36" Max Trench Bottom Depth 36" Gravel Depth N/A ☐ Gravity ☒ Pressure ☐ Slab ☒ Crawl Space ☐ Basement w/plumbing ☐ Basement wo/plumbing

☒ New System ☐ Repair ☐ Expansion System Type: I II III IV V VI

System Description: 25% REDUCTION, PUMP

Repair System Description: 50% REDUC, PUMP/LOW PRESS

Maintenance Agreement Required: ☐ Yes ☒ No

☒ House/Mod. Home ☐ Mobile Home ☐ Business ☐ Other


No. Bedrooms 3 No. Persons ___ No. Employees ___

Water Supply: ☐ Individual ☒ Public ☐ Community

Comments/Conditions: (1) SEE ATTACHED PUMP & PRESSURE MANIFOLD DIAGRAMS.

Comments/Conditions: POLY LOK FILTER & RISER PUMP TANK & MARKER

INITIAL SITE SKETCH *SCALE: ~1" = 40'

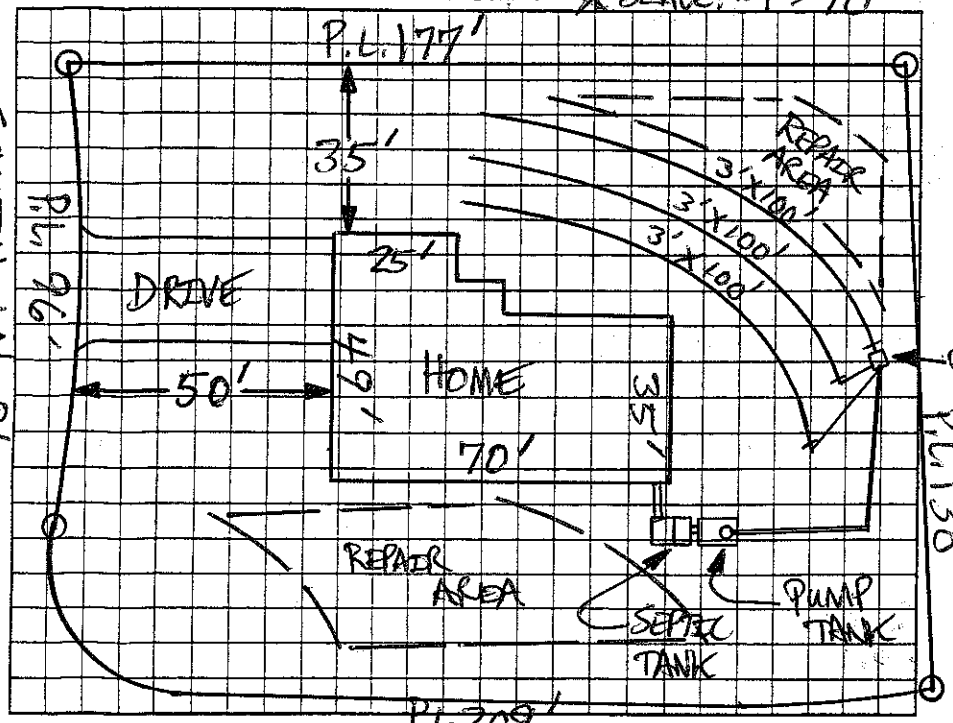

AS BUILT SKETCH

Permit can be suspended or revoked if any false information is supplied toward securing the permit/any unauthorized changes are made to the site/any unauthorized changes are made in the installation of the system. Improvement Permit with plat valid without expiration. Improvement Permit with site plan valid for sixty months. Authorization to Construct is valid for a period equal to that of Improvement Permit – not to exceed sixty months.

Signed: Lee Hoots date 11-7-06

Improvement Permit by: Patti Pittard date 10/27/06

Authorization to Construct by: Patti Pittard date 10/27/06

Installed by: BRENT GALLIMORE

Operation Permit by: JMD date 5-23-07

Existing System Inspection by: ___ date ___

HEALTH DEPT. COPY: WHITE OWNER COPY (FINAL): YELLOW OWNER COPY (INITIAL): PINK

