IREDELL COUNTY HEALTH DEPARTMENT

STATESVILLE 704-878-5305 MOORESVILLE 704-664-5281

IMPROVEMENT PERMIT / AUTHORIZATION TO CONSTRUCT / OPERATION PERMIT / EXISTING SYSTEM INSPECTION

PERMIT# 83393 PIN# 4747550151 DATE 8-31-99

OWNER OR CONTRACTOR Perry Church PHONE: Business _____ Home _____

ADDRESS 770 Whites Farm Rd Statesville

LOCATION 21N TL Shoemaker To Whites Farm 1/2 mi Past branch on Rt.

SUBDIVISION _____ BLOCK / SECTION _____ LOT _____ LOT AREA 3.0 acres SITE CLASS PS DESIGN FLOW 360 L.T.A.R. .13

Septic Tank: 1000 Gallons; STB 1012 Date 2-14-01
Pump Tank: _____ Gallons; PT _____ Date _____
Pump Make: _____ Model _____ Serial No _____
Nitrification Field: No Fields 1 Square Feet 1200 Linear Feet 400
No Lines 4 Trench Width 36" Max Trench Bottom Depth 36" Gravel Depth 12"

☑ New System ☐ Repair System Type: I ☑ II, III, IV, V, VI
System Description: Conv. Gravity
Repair System Description: Pump To 25% Rate
Maintenance Agreement Required: ☐ Yes ☑ No


☑ House/Mod. Home No. Bedrooms 3
☐ Mobile Home No. Bathrooms 2
☐ Business No. Employees _____
☐ Other _____
☐ Slab ☐ Crawl Space ☐ Basement w/plumbing ☐ Basement wo/plumbing

Water Supply: ☑ Individual ☐ Public ☐ Community


Comments/Conditions: Stream

Comments/Conditions: -Poly Lok Filter Installed -Septic Tank marker

INITIAL SITE SKETCH

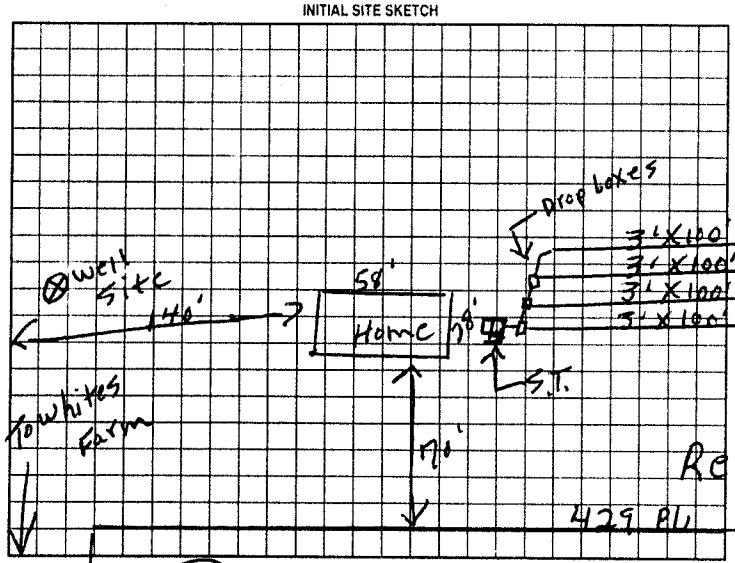

AS BUILT SKETCH

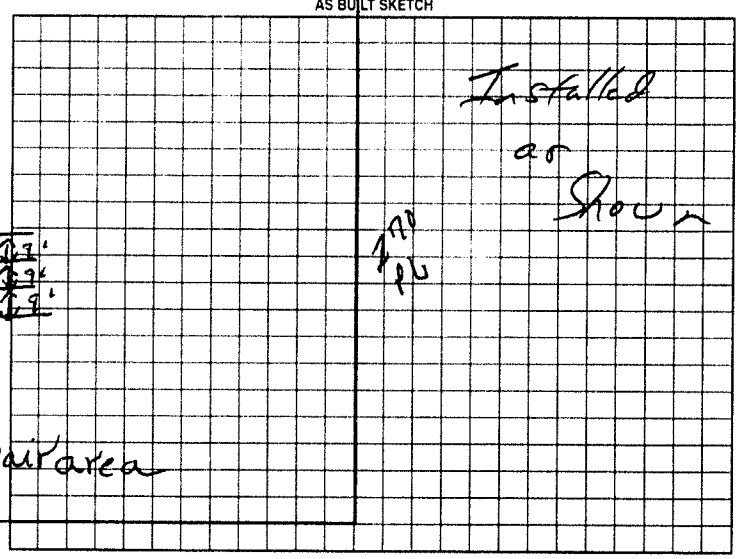

Permit can be suspended or revoked if any false information is supplied toward securing the permit/any unauthorized changes are made to the site/any unauthorized changes are made in the installation of the system. Improvement Permit with plat valid without expiration. Improvement Permit with site plan valid for sixty months. Authorization to Construct is valid for a period equal to that of Improvement Permit - not to exceed sixty months.

Signed: T. Perry W Church date 8-31-99 Installed by: A-1 Backhoe

Improvement Permit by: P.C. Moore date 8-31-99 Operation Permit by: William Johnson date 4/23/01

Authorization to Construct by: P.C. Moore date 8-31-99 Existing System Inspection by: _____ date _____

HEALTH DEPT. COPY: WHITE OWNER COPY (FINAL): YELLOW OWNER COPY (INITIAL): PINK