IREDELL COUNTY HEALTH DEPARTMENT - *ENVIRONMENTAL HEALTH* ☑ STATESVILLE OFFICE 704-878-5305 ☐ MOORESVILLE OFFICE 704-664-5281

IMPROVEMENT PERMIT / AUTHORIZATION TO CONSTRUCT / OPERATION PERMIT / EXISTING SYSTEM INSPECTION

PERMIT # 163468 PIN # 4747-55-4043 DATE 29 October 10

OWNER John & Lynn Taylor APPLICANT: PHONE: Home/Cell # (980) 253-9888 Business # 704-380-2860

SITE ADDRESS 212 Dunsdale Dr. Statesville OWNER / APPLICANT ADDRESS

SITE DIRECTIONS Shumaker Dr. TR Dunsdale Dr. ON Rt. before Stallion Ln.

SUBDIVISION Dunsdale BLOCK / SECTION LOT # 67 LOT AREA 0.646 DESIGN FLOW 360gpd L.T.A.R. 0.253/187

Septic Tank 1000 Gallons: STB Date

Pump Tank Gallons: P T Date

Pump Make Model Serial #

No. Nitrification Fields: 1 No. Lines 4 Linear Feet 360

Trench Width 36" Max. Trench Bottom Depth 24" Gravel Depth NA

☐ New System ☐ Repair ☐ Expansion System Type I II III IV V VI

System Description: 25% Reduction.

Repair System Description: 50% Reduction w/LPP dist.

Maintenance Agreement Required ☐ YES ☐ NO

☑ GRAVITY ☐ PRESSURE

☑ Residence No. Bedrooms 3

☐ Business No. Persons

☐ Other No. Employees

☐ Slab ☐ Crawl Space


☑ Basement w/plumbing ☐ Basement w/o plumbing

Water Supply: ☐ Private ☑ Public ☐ Community

Comments / Conditions

INITIAL SITE SKETCH

AS BUILT SKETCH

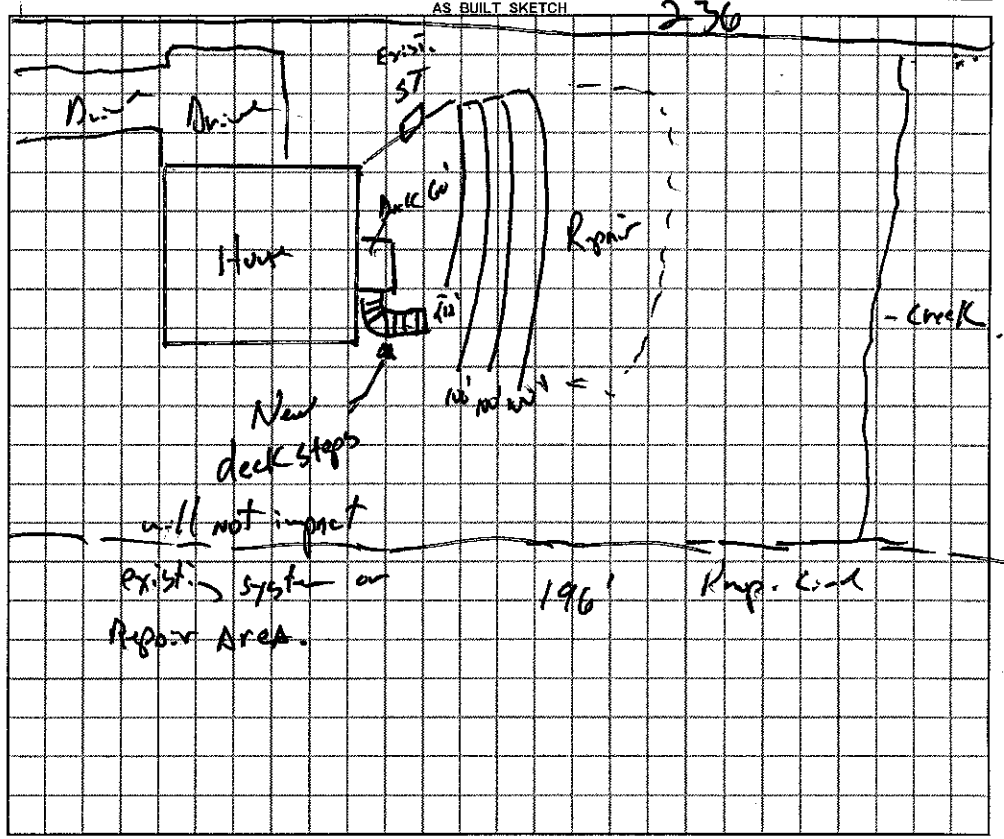

Permit can be suspended or revoked if any false information is supplied toward securing the permit / any unauthorized changes are made to the site / any unauthorized changes are made in the installation of the system.

☐ ***IMPROVEMENT PERMIT*** with plat valid without expiration. ☐ ***IMPROVEMENT PERMIT*** with plat valid without expiration. ☐ ***AUTHORIZATION TO CONSTRUCT*** valid for period equal to IMPROVEMENT PERMIT--not to exceed 60 mo.

Owner / Applicant Signature: Date 11/8/10 Installed by:

IMPROVEMENT PERMIT by: REHS Date OPERATION PERMIT by: REHS Date

AUTHORIZATION TO CONSTRUCT by: REHS Date Existing System Inspected by: REHS Date 29 Oct 10

YOU SHOULD CONTACT A LOCATOR SERVICE PRIOR TO ANY EXCAVATION

White Copy – Environmental Health YELLOW COPY (Final) Owner / Applicant PINK COPY (Initial) Owner / Applicant