IREDELL COUNTY HEALTH DEPARTMENT

STATESVILLE 704-878-5305 MOORESVILLE 704-664-5281

IMPROVEMENT PERMIT / AUTHORIZATION TO CONSTRUCT / OPERATION PERMIT / EXISTING SYSTEM INSPECTION

PERMIT# 143741 PIN# 4747554148 DATE 7-30-07

OWNER OR APPLICANT Russell Simyre PHONE: Business Home 704 907 0626

ADDRESS 206 Donsdale Dr.

LOCATION Whites Farm Rd. (R) Donsdale Dr, Property on (R)

SUBDIVISION Donsdale BLOCK / SECTION 2 LOT 66 LOT AREA .611 SITE CLASS. P3 DESIGN FLOW 360 L.T.A.R. .25

Septic Tank: 1050 Gallons; STB 1012 Date 6-27-07
Pump Tank: Gallons; PT Date
Pump Make: Model Serial No.
Nitrification Field: No Fields 1 Square Feet 1440 Linear Feet 240
No Lines 5 Trench Width 24" Max Trench Bottom Depth 36" Gravel Depth Gravity ☐ Pressure

☒ New System ☐ Repair ☐ Expansion System Type: I II (III) IV V VI
System Description: 50% PPBPS - Gravity
Repair System Description: LPP System
Maintenance Agreement Required: ☐ Yes ☒ No

☒ House/Mod. Home No. Bedrooms 3
☐ Mobile Home No. Persons
☐ Business No. Employees
☐ Other


Water Supply: ☐ Individual ☒ Public ☐ Community

☐ Slab ☐ Crawl Space ☒ Basement w/plumbing ☐ Basement wo/plumbing

Comments:/Conditions: ★ Must use Effluent Splitter ★
★ Keep system as high up hill as possible ★

Comments:/Conditions: Yellow Lug-Tit

INITIAL SITE SKETCH

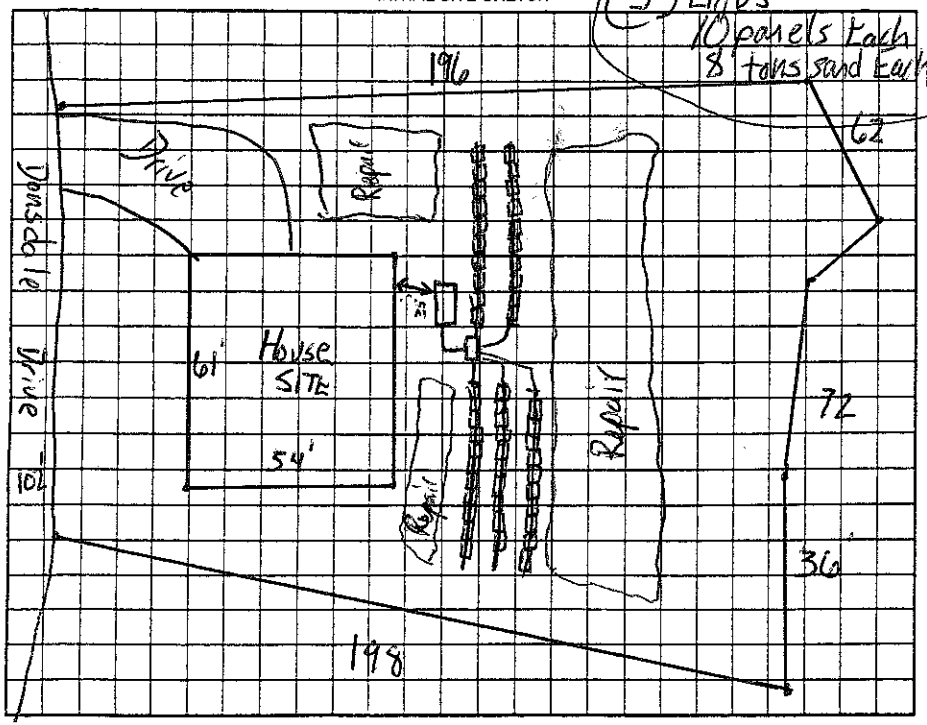

AS BUILT SKETCH

Permit can be suspended or revoked if any false information is supplied toward securing the permit/any unauthorized changes are made to the site/any unauthorized changes are made in the installation of the system. Improvement Permit with plat valid without expiration ☐ Improvement Permit with site plan valid for sixty months ☒ Authorization to Construct is valid for a period equal to that of Improvement Permit – not to exceed sixty months.

Signed: Russell Simyre date 7-31-07
Improvement Permit by: James Stevens date 7-30-07
Authorizat [illegible] date 7-31-07

Installed by: Craig Thompson
Operation Permit by: [illegible] date 4-1-08
Existing System Inspection by: date

HEALTH DEPT. COPY: WHITE OWNER COPY (FINAL): YELLOW OWNER COPY (INITIAL): PINK