IREDELL COUNTY HEALTH DEPARTMENT

STATESVILLE 704-878-5305 MOORESVILLE 704-664-5281

IMPROVEMENT PERMIT / AUTHORIZATION TO CONSTRUCT / OPERATION PERMIT / EXISTING SYSTEM INSPECTION

CI

PERMIT# 130995 PIN# 4747 55 5566 DATE 9/23/05

OWNER OR CONTRACTOR WILLIAM HOUPE JR PHONE: Business Home

ADDRESS 841 WHITES FARM RD STATESVILLE, NC 28677

LOCATION 21N @ WHITES FARM @ OONSDALE DR 188 OONSDALE DR

SUBDIVISION OONSDALE BLOCK / SECTION 1 LOT 63 LOT AREA .90 ACRES SITE CLASS PS DESIGN FLOW 360 GPD L.T.A.R. .3

Septic Tank: 1000 Gallons; STB 1012 Date 7-31-05
Pump Tank: Gallons; PT Date
Pump Make: Model Serial No.
Nitrification Field: No Fields 1 Square Feet 900 1200 Linear Feet 300
No Lines 4 Trench Width 36" Max Trench Bottom Depth 24" Gravel Depth NA

☒ New System ☐ Repair System Type: I, II, III, IV, V, VI
System Description: GRAVITY 25% REDUCTION
Repair System Description: GRAVITY PDBPS
Maintenance Agreement Required: ☐ Yes ☒ No

☒ House/Mod. Home No. Bedrooms 3
☐ Mobile Home No. Bathrooms
☐ Business No. Employees
☐ Other

☐ Slab ☒ Crawl Space ☐ Basement w/plumbing ☐ Basement wo/plumbing


Water Supply: ☐ Individual ☒ Public ☐ Community

Comments/Conditions: INSTALL ON CONTOUR. MAINTAIN SETBACKS. INSTALL SUBSURFACE INTERCEPTOR DRAIN AS SHOWN.


SCALE: 1" = 50'

Comments/Conditions: TUFFTITE F.I. & MARKER INSTALLER SHOWED ME MARKED P/L. LAST LINE IS 10' OFF.

INITIAL SITE SKETCH

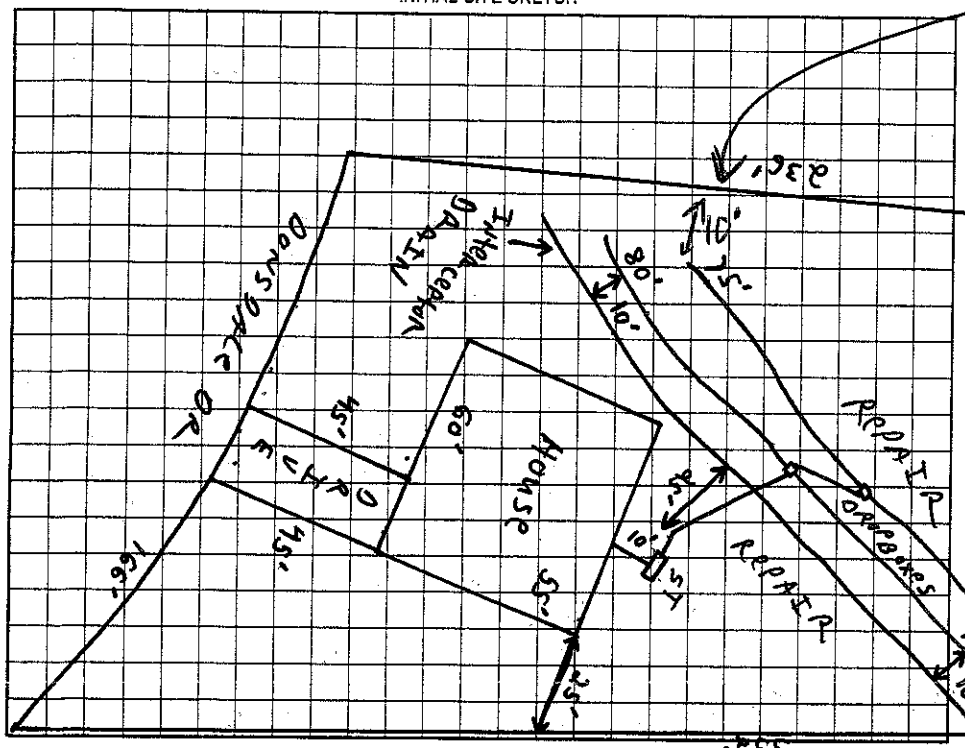

AS BUILT SKETCH

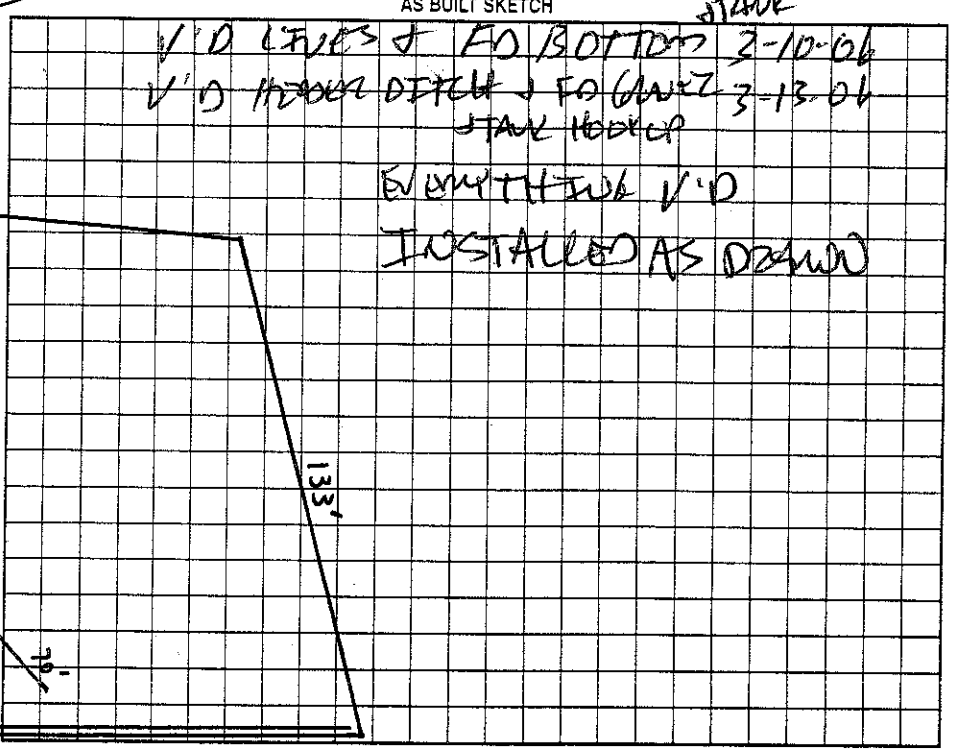

Permit can be suspended or revoked if any false information is supplied toward securing the permit/any unauthorized changes are made to the site/any unauthorized changes are made in the installation of the system. Improvement Permit with plat valid without expiration. Improvement Permit with site plan valid for sixty months. Authorization to Construct is valid for a period equal to that of Improvement Permit – not to exceed sixty months.

Signed: date 9-23-05 Installed by: CRAIG THOMPSON

Improvement Permit by: date 9/23/05 Operation Permit by: date 3-13-06

Authorization to Construct by: date 9/23/05 Existing System Inspection by: date

HEALTH DEPT. COPY: WHITE OWNER COPY (FINAL): YELLOW OWNER COPY (INITIAL): PINK