IREDELL COUNTY HEALTH DEPARTMENT (CT)

STATESVILLE 704-878-5305 MOORESVILLE 704-664-5281

IMPROVEMENT PERMIT / AUTHORIZATION TO CONSTRUCT / OPERATION PERMIT / EXISTING SYSTEM INSPECTION

PERMIT# 127777 PIN# 4747-55-5783 DATE 6-3-05

OWNER OR CONTRACTOR BUILT BY BALOUGH, INC. PHONE: Business 336-902-9025 Home 336-984-2013

ADDRESS 819 CHERRY GROVE LANE, N. WILKESBORO NC 28659

LOCATION JENNINGS ROAD, TL WHITES FARM RD, TL DONSDALE DR, TR CLARICE CT, LOT ON LEFT AT END

SUBDIVISION DONSDALE BLOCK / SECTION LOT 53 LOT AREA 0.797 ACRE SITE CLASS. PS DESIGN FLOW 360 L.T.A.R. 0.30 GPD/FT²

Septic Tank: 1000 Gallons; STB 1072 Date 6-30-05
Pump Tank: Gallons; PT Date
Pump Make: Model Serial No.
Nitrification Field: No Fields 1 Square Feet 1200 Linear Feet 300'
No Lines FOUR Trench Width 36" Max Trench Bottom Depth 26" Gravel Depth 12"

☑ New System ☐ Repair System Type: I, II, III, IV, V, VI
System Description: 25% REDUCTION GRAVITY
Repair System Description: 50% REDUCTION, LOW PRESSURE
Maintenance Agreement Required: ☐ Yes ☑ No ☐ Other
☐ Slab ☑ Crawl Space ☐ Basement w/plumbing ☐ Basement wo/plumbing


☑ House/Mod. Home ☐ Mobile Home ☐ Business No. Bedrooms 3 No. Bathrooms No. Employees

Water Supply: ☐ Individual ☑ Public ☐ Community

Comments:/Conditions: INSTALL 25% REDUCTION SYSTEM ON CONTOUR AS SHOWN NO DEEPER THAN 26"

Comments:/Conditions: Septic tank Maint. yearly Inspection

INITIAL SITE SKETCH

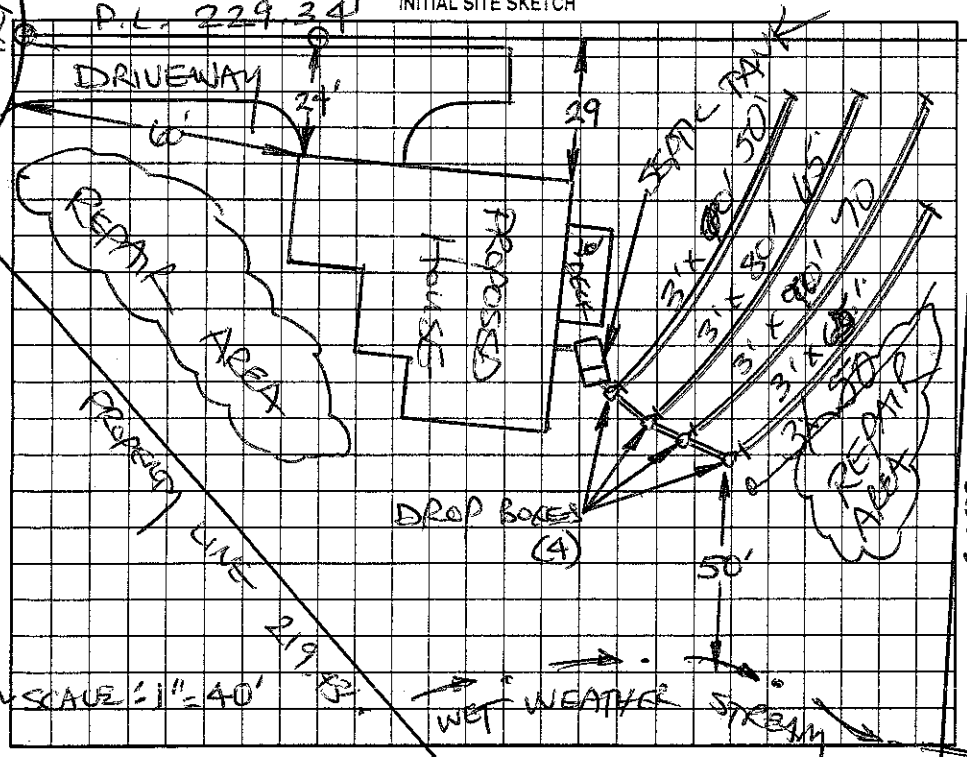

AS BUILT SKETCH

Permit can be suspended or revoked if any false information is supplied toward securing the permit/any unauthorized changes are made to the site/any unauthorized changes are made in the installation of the system. Improvement Permit with plat valid without expiration. Improvement Permit with site plan valid for sixty months. Authorization to Construct is valid for a period equal to that of Improvement Permit -- not to exceed sixty months.

Signed: [signature] date 6-3-05 Installed by: Steve Hedrick

Improvement Permit by: STEVE HEDRICK date 6-3-05 Operation Permit by: [signature] date 6-8-06

Authorization to Construct by: STEVE HEDRICK date 6-3-05 Existing System Inspection by: date

HEALTH DEPT. COPY: WHITE OWNER COPY (FINAL): YELLOW OWNER COPY (INITIAL): PINK