IREDELL COUNTY HEALTH DEPARTMENT

Statesville Office (704) 878-5305 Mooresville Office (704) 660-3625 PERMIT # 177670

IMPROVEMENT PERMIT / AUTHORIZATION TO CONSTRUCT / OPERATION PERMIT / EXISTING SYSTEM

PIN # 4747557171

APPLICANT: Hendricks Builders APPLICANT ADDRESS: 346 New Sterling Rd.

SITE ADDRESS: 111 Stallion Ln PHONE: 704-380-3806 ALT. PHONE: N/A

SITE DIRECTIONS: Hwy 21N TL Jennings Rd. TL Whites Farm Rd. TL Donsdale Dr TL Stallion Ln.

SUBDIVISION: Donsdale SECTION: 2 LOT # 16 LOT AREA: 0.591 DESIGN FLOW: 480gpd L.T.A.R.: 0.3

Septic Tank	1000 (gal)	STB	1017	Date	11-1-12	☑ New System	☐ Repair	☐ Expansion	System Type: I II (III) IV V VI
Pump Tank	(gal)	PT		Date		System Description:	25% Reduction		
Pump Make		Model		Serial #		Repair System Description:	Low Pressure PPBPS		
# Nitrification Fields	1	# Lines	6	Linear Ft:	400	Maintenance Agreement Required:	☐ YES	☑ NO	
Trench Width	36"	Max. Trench Bottom Depth	36"	Gravel Depth	N/A	☑ GRAVITY	☐ PRESSURE		

☑ Residence No. Bedrooms 4 — Water Supply: ☐ Private ☑ Public ☐ Community

☐ Business No. Persons


☐ Other No. Employees

☐ Slab ☑ Crawl Space

☐ Basement w/plumbing ☐ Basement w/o plumbing

Comments / Conditions: Install a 25% Reduction system on contour with serial distribution. Do Not grade for house site.

INITIAL SITE SKETCH

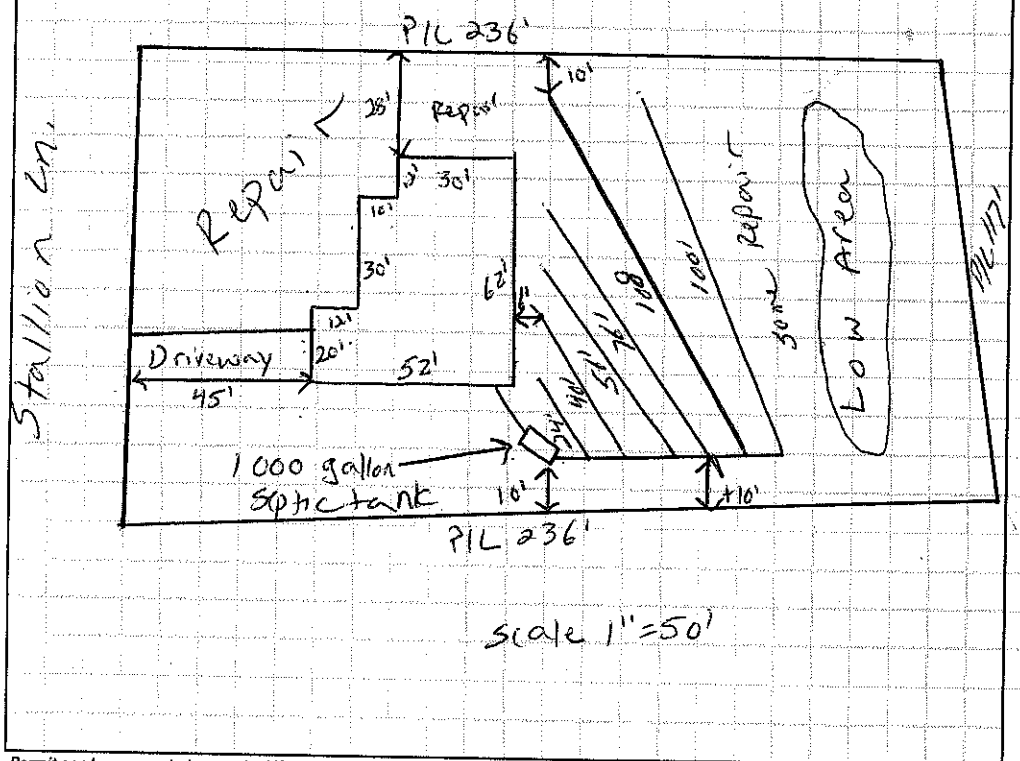

Scale 1"=50'

AS BUILT SKETCH

Permit can be suspended or revoked if any false information is supplied toward securing the permit / any unauthorized changes are made to the site / any unauthorized changes are made in the installation of the system. **CONTACT A LOCATOR SERVICE PRIOR TO ANY EXCAVATION**

☐ **IMPROVEMENT PERMIT** *with plat* valid without expiration. ☑ **IMPROVEMENT PERMIT** *with site plan* valid for 60 mos. ☑ **AUTHORIZATION TO CONSTRUCT** valid for period equal to IMPROVEMENT PERMIT--not to exceed 60 mo.

Owner / Applicant Signature: Martin Hendricks Date: 4-1-13 Installed by: Frye Grading

IMPROVEMENT PERMIT by: Justin Henderson Date: 3-28-13 OPERATION PERMIT by: [signature] Date: 9-11-13

AUTHORIZATION TO CONSTRUCT by: Justin Henderson Date: 3-28-13 Existing System Inspected by: Date:

Health Dept. Copy - WHITE Applicant (Final Approval) - YELLOW Applicant (Conditional Approval) - PINK