IREDELL COUNTY HEALTH DEPARTMENT

STATESVILLE 704-878-5305 MOORESVILLE 704-664-5281

IMPROVEMENT PERMIT / AUTHORIZATION TO CONSTRUCT / OPERATION PERMIT / EXISTING SYSTEM INSPECTION

PERMIT# 12480 PIN# 4747557998 DATE 12-1-05

OWNER OR CONTRACTOR Jeff Jones PHONE: Business 704-902-2772 Home

ADDRESS 143 Oak Grove Statesville NC 28677

LOCATION 21N to White Sand Rd. (L) Dondale (R) Chase 2N (L) on left

SUBDIVISION Dondale BLOCK / SECTION I LOT 56 LOT AREA SITE CLASS. DESIGN FLOW 360 L.T.A.R. .3

Septic Tank: 1000 Gallons; STB 1012 Date 10-5-05

Pump Tank: Gallons; PT Date

Pump Make: Model Serial No.

Nitrification Field: No Fields Square Feet 1200 Linear Feet 300

No Lines 4 Trench Width 36" Max Trench Bottom Depth 24" Gravel Depth NA

☑ New System ☐ Repair System Type: I, II, III, IV, V, VI

System Description: 25% Graded

Repair System Description: 25% Low Pressure

Maintenance Agreement Required: ☐ Yes ☑ No

☑ House/Mod. Home No. Bedrooms 2

☐ Mobile Home No. Bathrooms

☐ Business No. Employees

☐ Other


☐ Slab ☑ Crawl Space ☐ Basement w/plumbing ☐ Basement wo/plumbing

Water Supply: ☐ Individual ☑ Public ☐ Community


Comments:/Conditions: Use T-Splitter - Top (3) lines Distribution box - equal distribution Bottom (3) Drop Boxes

Comments:/Conditions: Install as per as built mistakes all set backs Yellow Filter 10-13-05

INITIAL SITE SKETCH

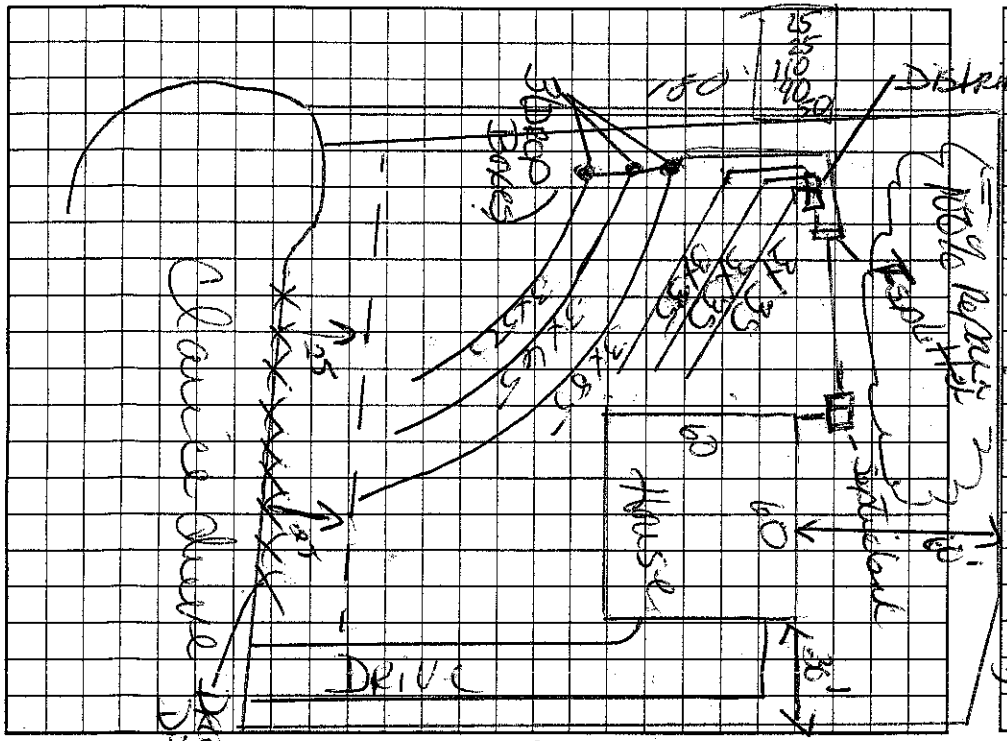

AS BUILT SKETCH

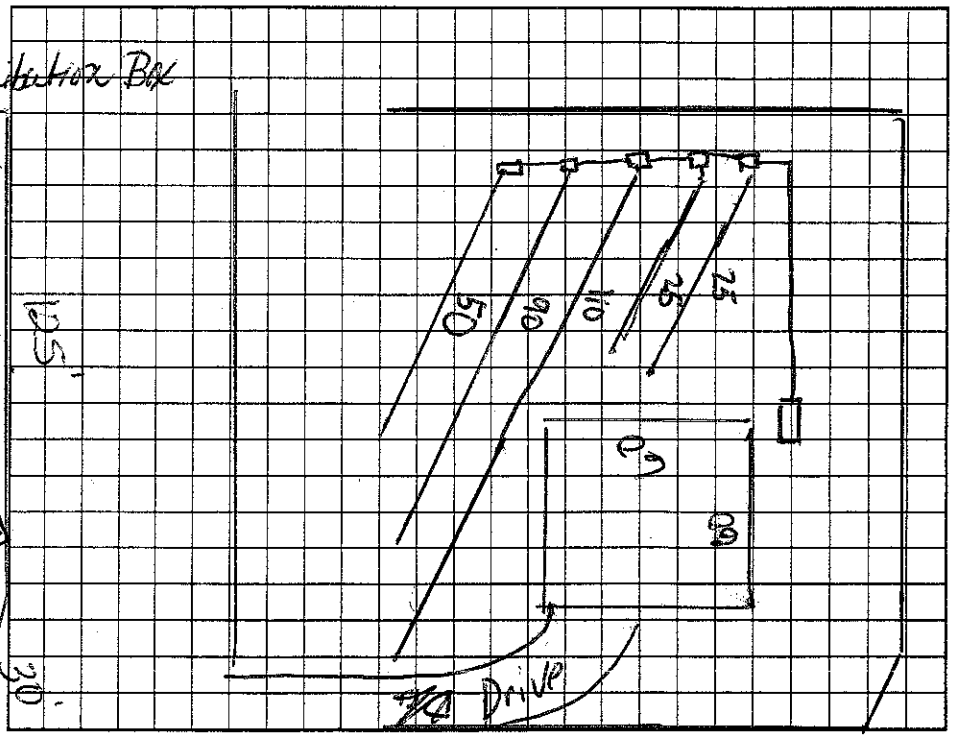

Permit can be suspended or revoked if any false information is supplied toward securing the permit/any unauthorized changes are made to the site/any unauthorized changes are made in the installation of the system. Improvement Permit with plat valid without expiration. Improvement Permit with site plan valid for sixty months. Authorization to Construct is valid for a period equal to that of Improvement Permit – not to exceed sixty months.

Signed: date 12-1-05 Installed by: Craig Thompson

Improvement Permit by: date 12-1-05 Operation Permit by: date 5-19-06

Authorization to Construct by: date 12-8-05 Existing System Inspection by: date

HEALTH DEPT. COPY: WHITE OWNER COPY (FINAL): YELLOW OWNER COPY (INITIAL): PINK