IREDELL COUNTY HEALTH DEPARTMENT

STATESVILLE 704-878-5305 MOORESVILLE 704-664-5281

IMPROVEMENT PERMIT / AUTHORIZATION TO CONSTRUCT / OPERATION PERMIT / EXISTING SYSTEM INSPECTION

PERMIT# 13899 20 PIN# 4747558198

OWNER OR APPLICANT Alan Hebert

ADDRESS Stallion Lane PHONE: Business 704 881 1611 Home 828 733 9175

LOCATION 177 to exit 52, right on Hwy 21, left on Jennings Rd, left on White Farm Rd, left on Dansdale, left on Stallion, property on left

SUBDIVISION Dansdale BLOCK / SECTION 2 LOT 17 LOT AREA .64 SITE CLASS. P5 DESIGN FLOW 480 L.T.A.R. 3

DATE 12-22-06

Septic Tank: 1000 Gallons; STB 760 Date 4-25-07

Pump Tank: ____ Gallons; PT ____ Date ____

Pump Make: ____ Model ____ Serial No. ____

Nitrification Field: No Fields 1 Square Feet 1600 Linear Feet 400

No Lines 3 Trench Width 36" Max Trench Bottom Depth 36" Gravel Depth ____

[X] New System [ ] Repair [ ] Expansion System Type: I II III IV V VI

System Description: 25% Reduction

Repair System Description: 50% Reduction

Maintenance Agreement Required: [ ] Yes [X] No

[X] House/Mod. Home [ ] Mobile Home [ ] Business [ ] Other

No. Bedrooms 4 No. Persons ____ No. Employees ____

Water Supply: [ ] Individual [X] Public [ ] Community


[X] Gravity [ ] Pressure [ ] Slab [X] Crawl Space [ ] Basement w/plumbing [ ] Basement wo/plumbing

Comments:/Conditions:

Comments:/Conditions:

Rick Dalrymple
Septic tank inspector

INITIAL SITE SKETCH

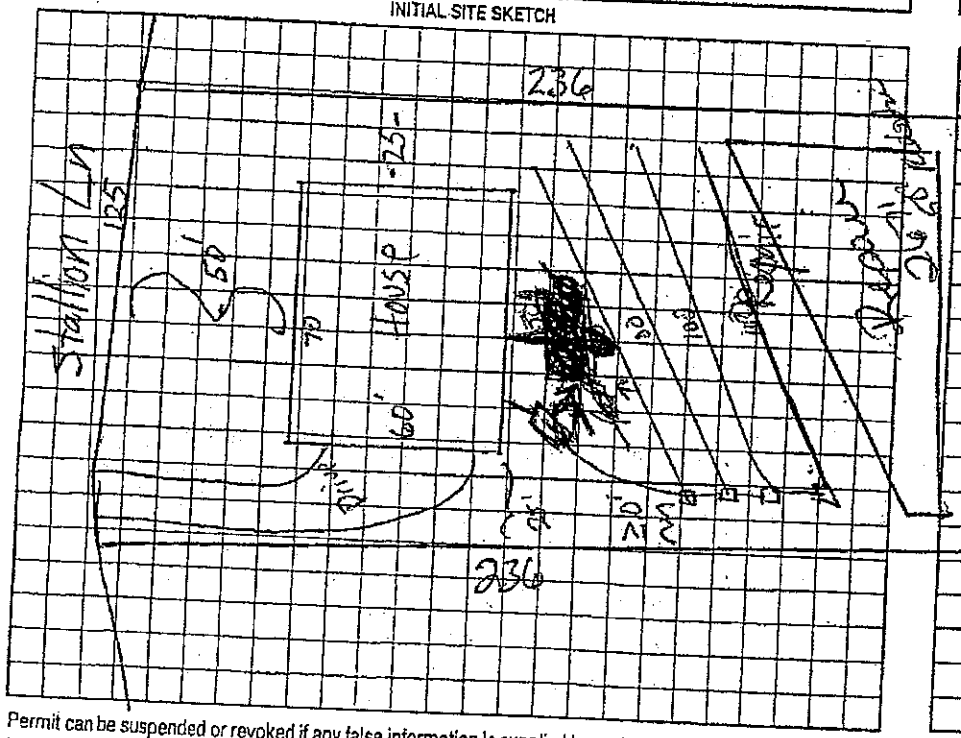

AS BUILT SKETCH

Sand at dispersal
Unfinished

Location of the proposed screened-in existing porch addition does not appear to impact the existing on-site septic system.**NOTE:

REHS

Date: 9-19-12

ICHD-Environmental Health Division

PAID

Permit can be suspended or revoked if any false information is supplied toward securing the permit/any unauthorized changes are made to the site/any unauthorized changes are made in the installation of the system. Improvement Authorization to Construct is valid for a period equal to that of Improvement Permit – not to exceed sixty months.

Permit with plat valid without expiration ☐ Improvement Permit with site plan valid for sixty months ☐

Permit by: ____ date 12-22-06

Inspected by: ____ date 12-22-06

Installed by: Madison Brothers

Operation Permit by: ____ date 10 Sept 07

Existing System Inspection by: ____ date ____

HEALTH DEPT. COPY: WHITE OWNER COPY (FINAL): YELLOW OWNER COPY (INITIAL): PINK