IREDELL COUNTY HEALTH DEPARTMENT

STATESVILLE 704-878-5305 (1) MOORESVILLE 704-664-5281

IMPROVEMENT PERMIT / AUTHORIZATION TO CONSTRUCT / OPERATION PERMIT / EXISTING SYSTEM INSPECTION

PERMIT# 122064 PIN# 4747-55-8308 DATE 8/23/04

OWNER OR CONTRACTOR Cool Spring Builders Inc. PHONE: Business 336-399-5943 Home

ADDRESS 345 Old Mocksville Road Statesville, N.C. 28625

LOCATION Hwy 21 N, @ on Shumaker Grove Info Whites Farm Rd), @ Dons dale drive 3rd lot on left past Clarice CT.

SUBDIVISION Donsdale BLOCK / SECTION I LOT 13 LOT AREA .716 Acres SITE CLASS. FS DESIGN FLOW 360 L.T.A.R. .25 gpd/sqft

Septic Tank: 4000 Gallons; STB 1012 Date 8-30-04
Pump Tank: Gallons; PT Date
Pump Make: Model Serial No.
Nitrification Field: No Fields 1 Square Feet 1440/1440 Linear Feet 360
No Lines 3@120 Trench Width 36" Max Trench Bottom Depth 24" Gravel Depth

☒ New System ☐ Repair System Type: I, II, (III), IV, V, VI
System Description: Gravity, 25% Reduction
Repair System Description: Pump, LP Panel
Maintenance Agreement Required: ☐ Yes ☒ No


☒ House/Mod. Home No. Bedrooms 3
☐ Mobile Home No. Bathrooms 2
☐ Business No. Employees
☐ Other
☐ Slab ☒ Crawl Space ☐ Basement w/plumbing ☐ Basement wo/plumbing

Water Supply: ☐ Individual ☒ Public ☐ Community

Comments:/Conditions: (1) Install Sub surface drainage ditch as shown starting @ 36" deep (2) Install lines on contour (3) maintain proper set backs.

Comments:/Conditions: SEPTIC TANK WITH MARKER INSTALLED USING "TUFFTITE" FILTER

INITIAL SITE SKETCH

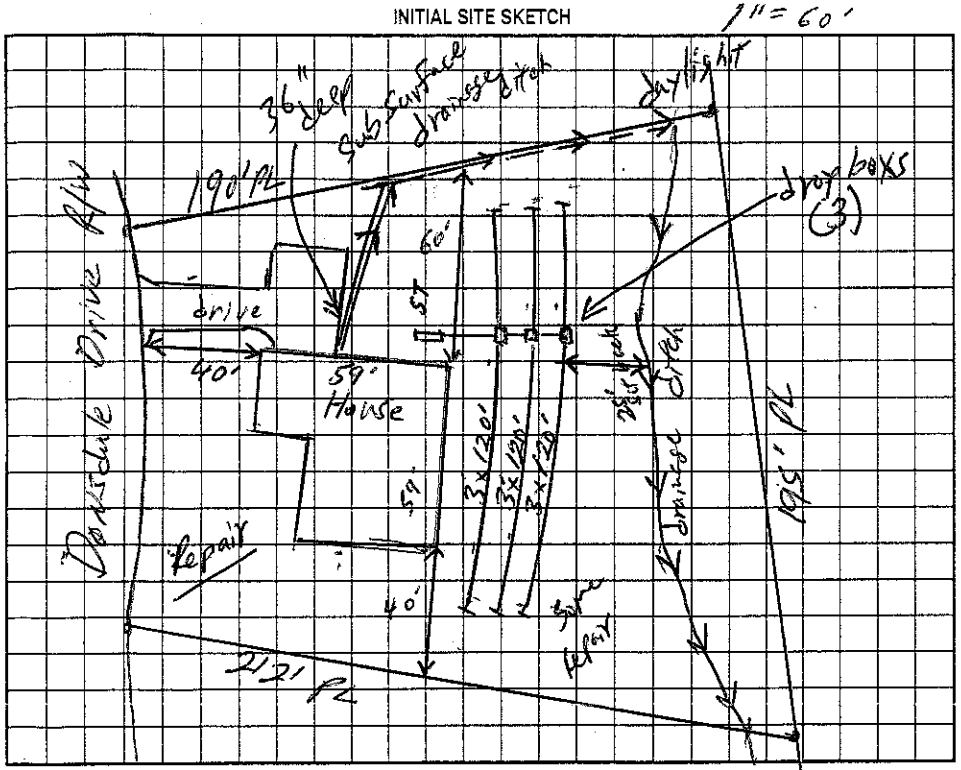

AS BUILT SKETCH

SYSTEM INSTALLED ACCORDING TO INITIAL SITE SKETCH USING 90 "INFILTRATOR QUIK-4" CHAMBERS

Permit can be suspended or revoked if any false information is supplied toward securing the permit/any unauthorized changes are made to the site/any unauthorized changes are made in the installation of the system. Improvement Permit with plat valid without expiration. Improvement Permit with site plan valid for sixty months. Authorization to Construct is valid for a period equal to that of Improvement Permit – not to exceed sixty months.

Signed: Michael W. Mould date 8/24/04 Installed by: PIEDMONT BACKHOE

Improvement Permit by: William O. Johnson date 8/23/04 Operation Permit by: STEVE HENRICK date 4-15-05

Authorization to Construct by: William O. Johnson date 8/23/04 Existing System Inspection by: date

HEALTH DEPT. COPY: WHITE OWNER COPY (FINAL): YELLOW OWNER COPY (INITIAL): PINK