CT

IREDELL COUNTY HEALTH DEPARTMENT

STATESVILLE 704-878-5305 MOORESVILLE 704-664-5281

IMPROVEMENT PERMIT / AUTHORIZATION TO CONSTRUCT / OPERATION PERMIT / EXISTING SYSTEM INSPECTION

PERMIT# 12990 PIN# 4949-55-8397 DATE 6/29/04

OWNER OR CONTRACTOR Trent Caviness PHONE: Business Cell (704) 902-1054 Home

ADDRESS 544 Poplar Springs Rd Statesville, N. C. 28625

LOCATION Hwy 21 N, (L) Shumaker turn into White Farm Rd, (R) Donsdale Drive, on right corner of Clarice Ct.

SUBDIVISION Donsdale BLOCK / SECTION 1 LOT 52 LOT AREA .744A SITE CLASS PS DESIGN FLOW 360 L.T.A.R. .25 gpd

Septic Tank: 4000 Gallons; STB 1007 Date 5-23-05
Pump Tank: Gallons; PT Date
Pump Make: Model Serial No.
Nitrification Field: No Fields 1 Square Feet Eqto 1440 Linear Feet 360'
No Lines 3 Trench Width 36" Max Trench Bottom Depth 36" Gravel Depth NA

☒ New System ☐ Repair System Type: I, II, III, IV, V, VI
System Description: Gravity, 25% Reduction
Repair System Description: Gravity, 25% Reduction
Maintenance Agreement Required: ☐ Yes ☒ No

☒ House/Mod. Home No. Bedrooms 3
☐ Mobile Home No. Bathrooms
☐ Business No. Employees
☐ Other
☐ Slab ☒ Crawl Space ☐ Basement w/plumbing ☐ Basement wo/plumbing


Water Supply: ☐ Individual ☒ Public ☐ Community

Comments:/Conditions:


Comments:/Conditions: ① "ZABEL" FILTER & MARKER ON TANK
② SYSTEM INSTALLED USING QUICK-4 CHAMBERS STD W H-10

Scale 1" = 50'

INITIAL SITE SKETCH

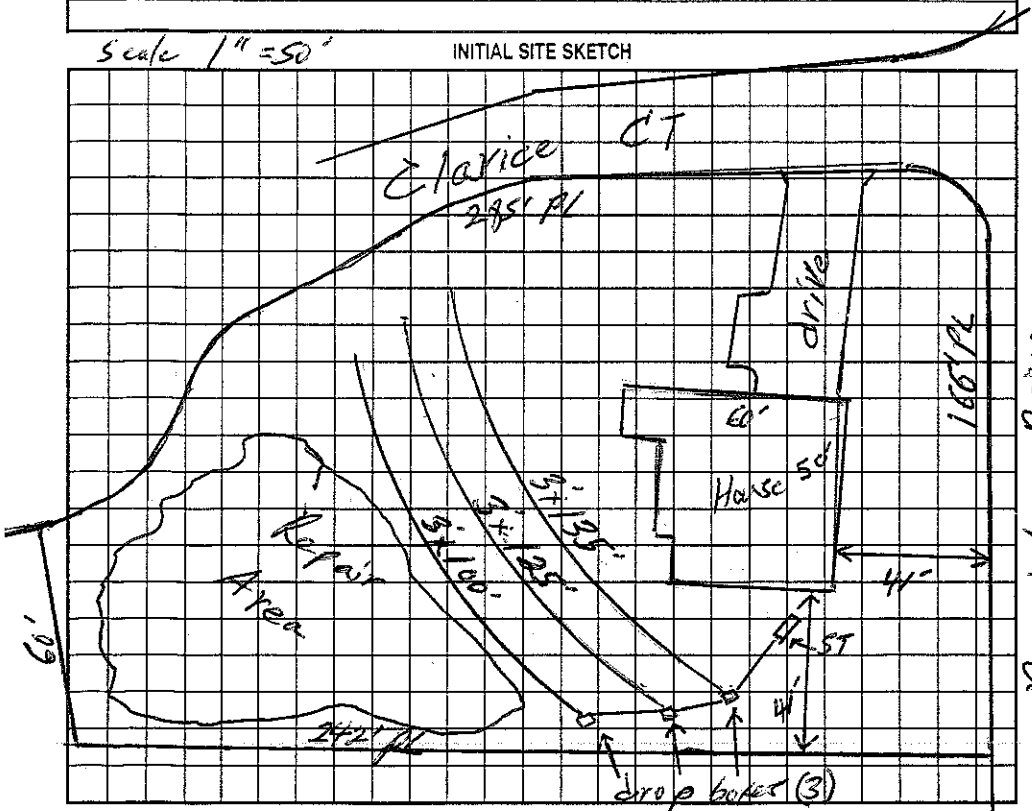

AS BUILT SKETCH

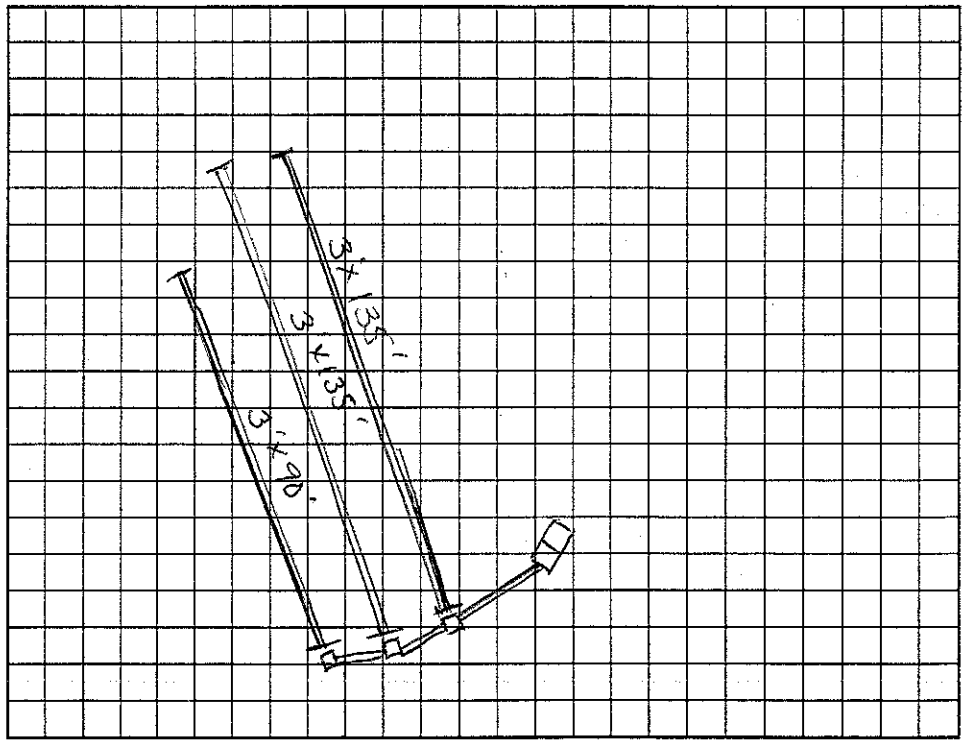

Permit can be suspended or revoked if any false information is supplied toward securing the permit/any unauthorized changes are made to the site/any unauthorized changes are made in the installation of the system. Improvement Permit with plat valid without expiration. Improvement Permit with site plan valid for sixty months. Authorization to Construct is valid for a period equal to that of Improvement Permit -- not to exceed sixty months.

Signed: Steven Trent Caviness date 7-13-04 Installed by: KENNY MADISON

Improvement Permit by: William O Johnson date 6/29/04 Operation Permit by: Christy M. Stevens, REHS date 7-15-05

Authorization to Construct by: William O Johnson date 6/29/04 Existing System Inspection by: date

HEALTH DEPT. COPY: WHITE OWNER COPY (FINAL): YELLOW OWNER COPY (INITIAL): PINK