# IREDELL COUNTY HEALTH DEPARTMENT

STATESVILLE 704-878-5305 MOORESVILLE 704-664-5281

**IMPROVEMENT PERMIT / AUTHORIZATION TO CONSTRUCT / OPERATION PERMIT / EXISTING SYSTEM INSPECTION**

PERMIT# 131753 PIN# 4747559848 DATE 11-2-05

OWNER OR CONTRACTOR Jeffrey Jones PHONE: Business 704 902 2772 Home

ADDRESS 143 Oak Grove Rd Statesville NC 28677

LOCATION 21N left Shoemaker (R) Woodale 6th lot on right

SUBDIVISION Woodale BLOCK / SECTION I LOT 57 LOT AREA .593 SITE CLASS. PS DESIGN FLOW 36 L.T.A.R. .3

Septic Tank: 1000 Gallons; STB 1012 Date 3-7-05
Pump Tank: Gallons; PT Date
Pump Make: Model Serial No.
Nitrification Field: No Fields Square Feet 1200 Linear Feet 300
No Lines 6 Trench Width 36 Max Trench Bottom Depth 36 Gravel Depth NA

☑ New System ☐ Repair System Type: I, (II), III, IV, V, VI
System Description: 25% Red. Gravity
Repair System Description: LPP
Maintenance Agreement Required: ☐ Yes ☐ No

☑ House/Mod. Home No. Bedrooms 3
☐ Mobile Home No. Bathrooms
☐ Business No. Employees
☐ Other


☐ Slab ☐ Crawl Space ☐ Basement w/plumbing ☐ Basement wo/plumbing

Water Supply:
☐ Individual
☑ Public
☐ Community

Comments:/Conditions: Install on contour - maintain all setbacks

Comments:/Conditions: Call Health department before installation for relayout.

INITIAL SITE SKETCH

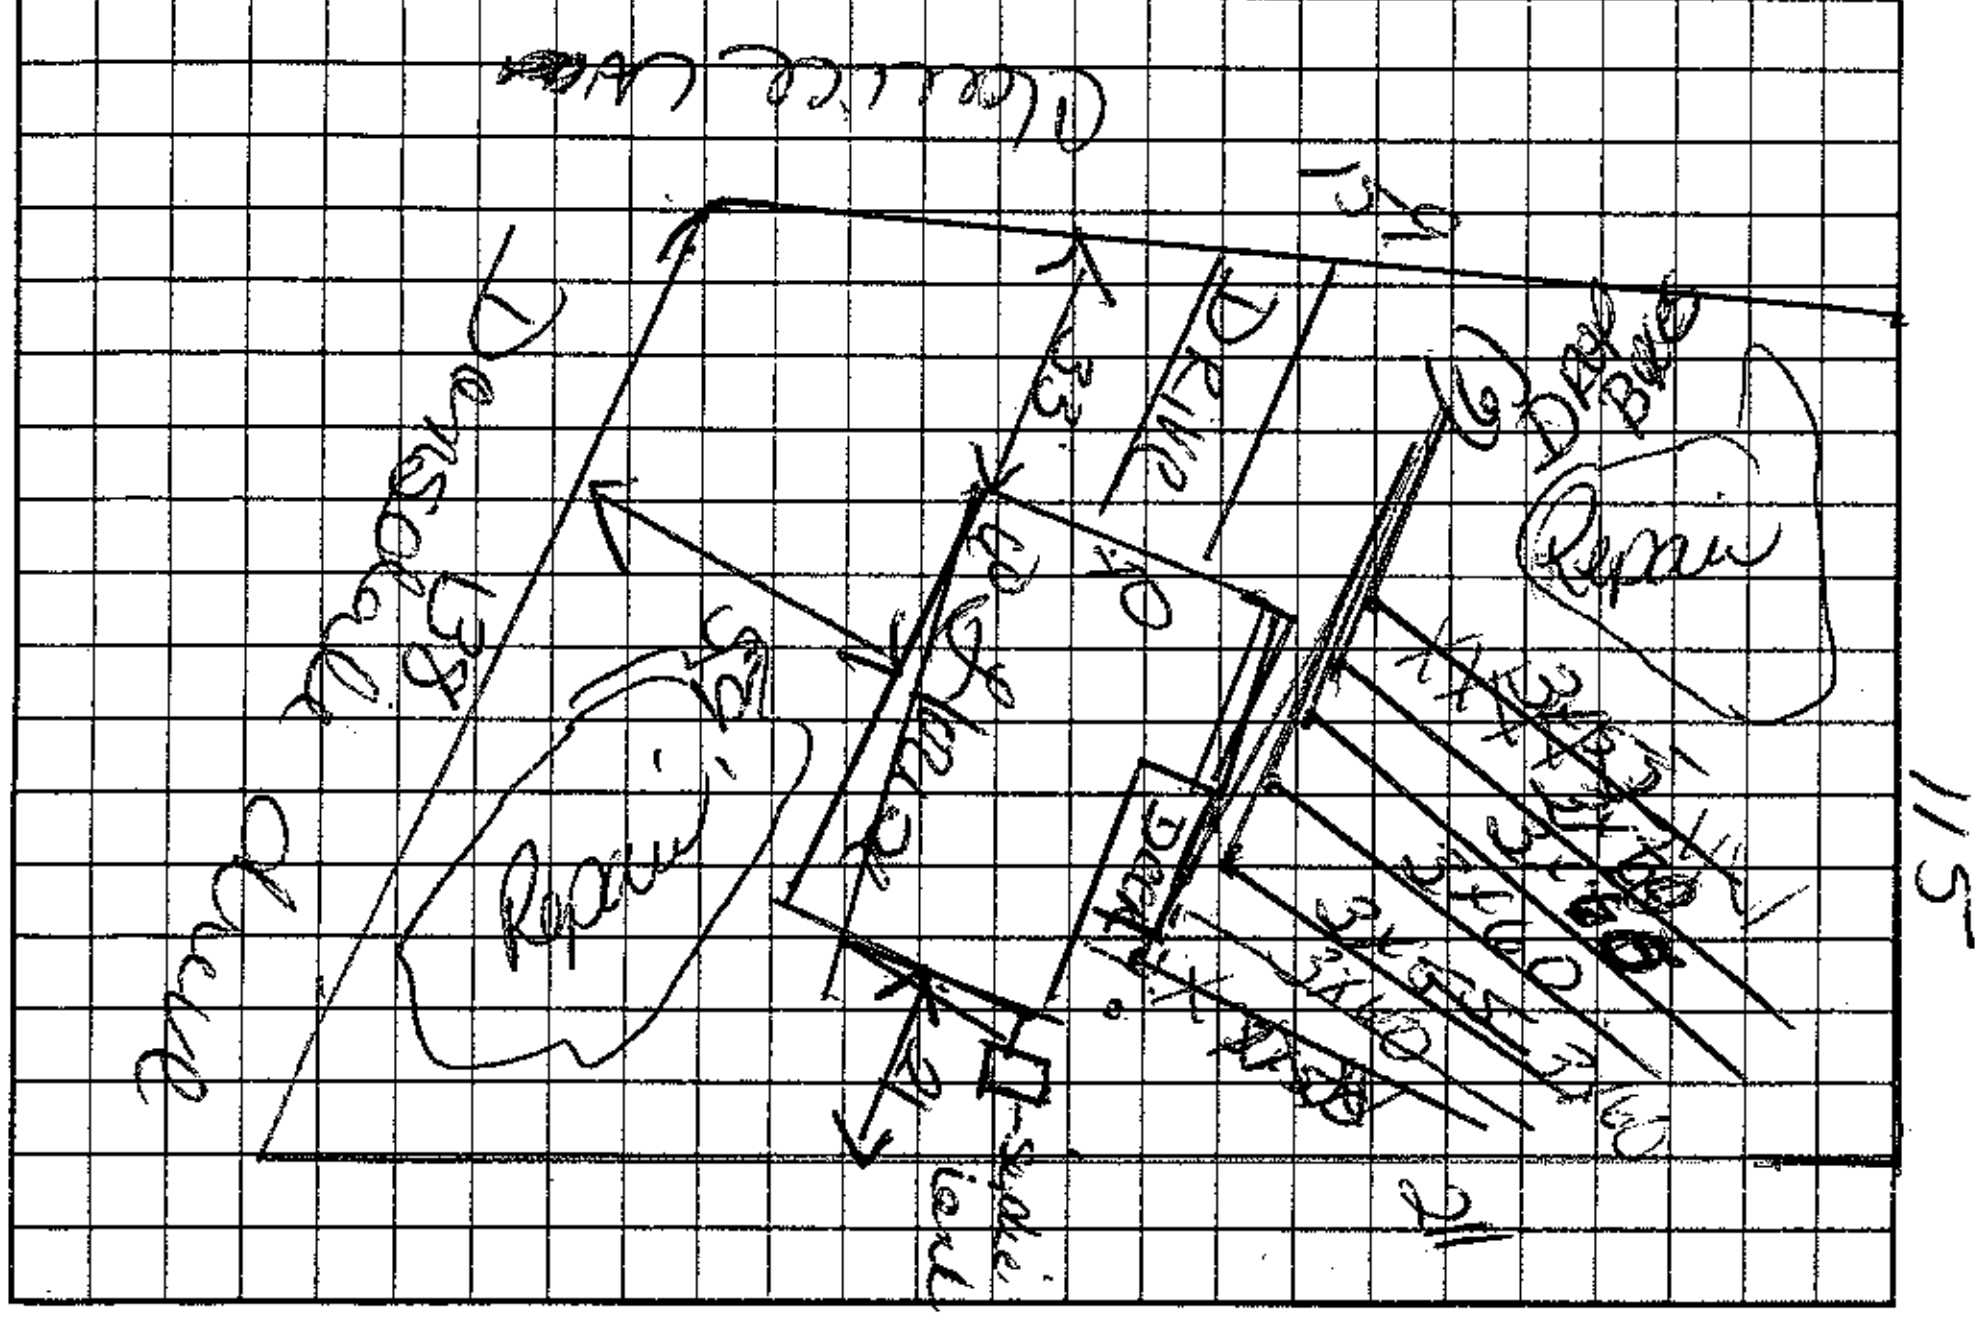

yellow Surf. Pre-filter
Septic Marker

AS BUILT SKETCH

Permit can be suspended or revoked if any false information is supplied toward securing the permit/any unauthorized changes are made to the site/any unauthorized changes are made in the installation of the system. Improvement Permit with plat valid without expiration. Improvement Permit with site plan valid for sixty months. Authorization to Construct is valid for a period equal to that of Improvement Permit – not to exceed sixty months.

Signed: Jeffrey Jones date 11-2-05 Installed by: Craig Thompson

Improvement Permit by: Perry Cook date 11-2-05 Operation Permit by: Perry Cook date 3-20-06

Authorization to Construct by: Perry Cook date 11-2-05 Existing System Inspection by: date

HEALTH DEPT. COPY: WHITE OWNER COPY (FINAL): YELLOW OWNER COPY (INITIAL): PINK