IREDELL COUNTY HEALTH DEPARTMENT

Statesville Office (704) 878-5305 Mooresville Office (704) 660-3625 PERMIT # 220353

IMPROVEMENT PERMIT / AUTHORIZATION TO CONSTRUCT / OPERATION PERMIT / EXISTING SYSTEM

PIN # 4747564247

APPLICANT: Dennis Deal APPLICANT ADDRESS: 576 Snow Creek Rd Statesville, NC 28625

SITE ADDRESS: 834 Whites Farm Rd Statesville NC PHONE: ALT. PHONE: 704 902-3978

SITE DIRECTIONS: I-77N TR Jam off exit 11 Jenning Rd TL Whites Farm Rd on left just past Donsdale D

SUBDIVISION: SECTION: LOT # 5 LOT AREA: 1.16 Ac DESIGN FLOW: 360gpd L.T.A.R.: .3

Septic Tank 1000 (gal) STB Infiltrator Date
Pump Tank (gal) PT Date
Pump Make Model Serial #
Nitrification Fields 1 # Lines 3 Linear Ft: 300'
Trench Width 36" Max. Trench Bottom Depth 36" Gravel Depth N/A

☒ New System ☐ Repair ☐ Expansion System Type: I II (III) IV V VI
System Description: Gravity - 25% Reduction
Repair System Description: Same
Maintenance Agreement Required: ☐ YES ☒ NO
☒ GRAVITY ☐ PRESSURE


☒ Residence No. Bedrooms 3
☐ Business No. Persons
☐ Other No. Employees
☐ Slab ☒ Crawl Space
☐ Basement w/plumbing ☐ Basement w/o plumbing

Water Supply: ☐ Private ☒ Public ☒ Community


Comments / Conditions: * Divert Storm/Surface Water away from Septic System
* Abandon existing well prior to Septic Installation

OK to use distribution box instead of Serial distribution.

INITIAL SITE SKETCH

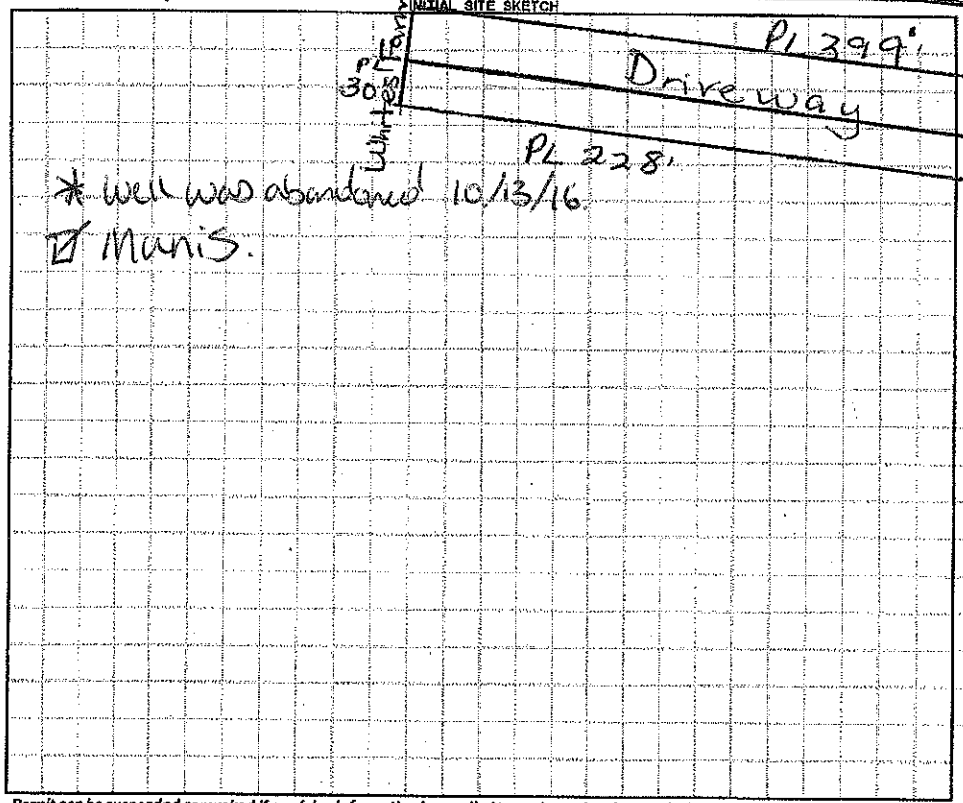

AS BUILT SKETCH

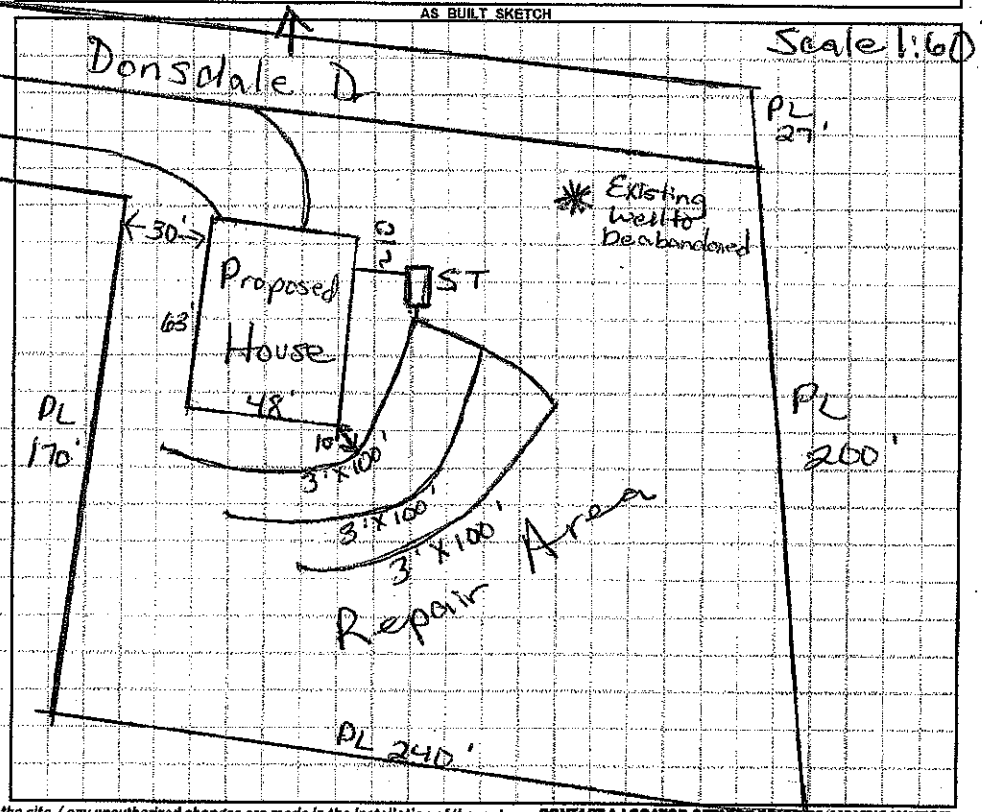

Permit can be suspended or revoked if any false information is supplied toward securing the permit / any unauthorized changes are made to the site / any unauthorized changes are made in the installation of the system. **CONTACT A LOCATOR SERVICE PRIOR TO ANY EXCAVATION**

☐ **IMPROVEMENT PERMIT** *with plat valid without expiration* ☐ **IMPROVEMENT PERMIT** *with site plan valid for 60 mos.* ☐ **AUTHORIZATION TO CONSTRUCT** *valid for period equal to IMPROVEMENT PERMIT--not to exceed 60 mo.*

Owner / Applicant Signature: Date: 8/30/16 Installed by: Ivy Grading + Septic

IMPROVEMENT PERMIT by: Marina Dotson RS Date: 8/29/16 OPERATION PERMIT by: B. Botkins Date: 4/12/17

AUTHORIZATION TO CONSTRUCT by: Marina Dotson RS Date: 8/29/16 Existing System Inspected by: Date:

Health Dept. Copy - WHITE Applicant (Final Approval) - YELLOW Applicant (Conditional Approval) - PINK