IREDELL COUNTY HEALTH DEPARTMENT

CALLED IN

STATESVILLE 704-878-5305 MOORESVILLE 704-664-5281

IMPROVEMENT PERMIT / AUTHORIZATION TO CONSTRUCT / OPERATION PERMIT / EXISTING SYSTEM INSPECTION

PERMIT# 128619 PIN# 4747566263 DATE 7-12-05

OWNER OR CONTRACTOR Brenda Johnson PHONE: Business 704-902-8396 Home 704-872-7062

ADDRESS 111 Calico Ln. Statesville 28625

LOCATION 21 N, TL Shumaker, TR Donsdale Dr, on right

SUBDIVISION Donsdale BLOCK / SECTION 1 LOT 62 LOT AREA .654 Ac. SITE CLASS PS DESIGN FLOW 360 L.T.A.R. .3

Septic Tank: 1000 Gallons; STB 1012 Date 5-27-05
Pump Tank: ____ Gallons; PT ____ Date ____
Pump Make: ____ Model ____ Serial No. ____
Nitrification Field: No Fields 1 Square Feet 1200 Linear Feet 300
No Lines 3 Trench Width 36" Max Trench Bottom Depth 36" Gravel Depth —

☒ New System ☐ Repair System Type: I, (II), III, IV, V, VI
System Description: 25% reduction, gravity
Repair System Description: 25 or 50% reduction
Maintenance Agreement Required: ☐ Yes ☒ No

☒ House/Mod. Home No. Bedrooms 3
☐ Mobile Home No. Bathrooms ____
☐ Business No. Employees ____
☐ Other ____


☐ Slab ☒ Crawl Space ☐ Basement w/plumbing ☐ Basement wo/plumbing

Water Supply: ☐ Individual ☒ Public ☐ Community


Comments:/Conditions:

Comments:/Conditions:
√

INITIAL SITE SKETCH

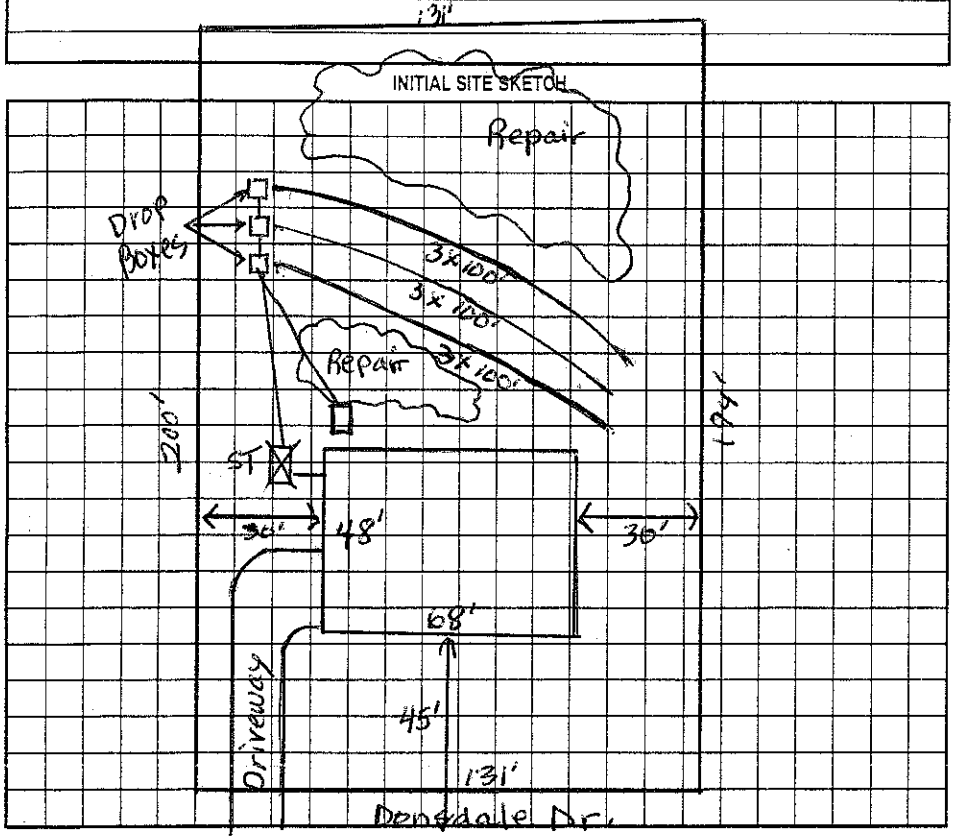

AS BUILT SKETCH

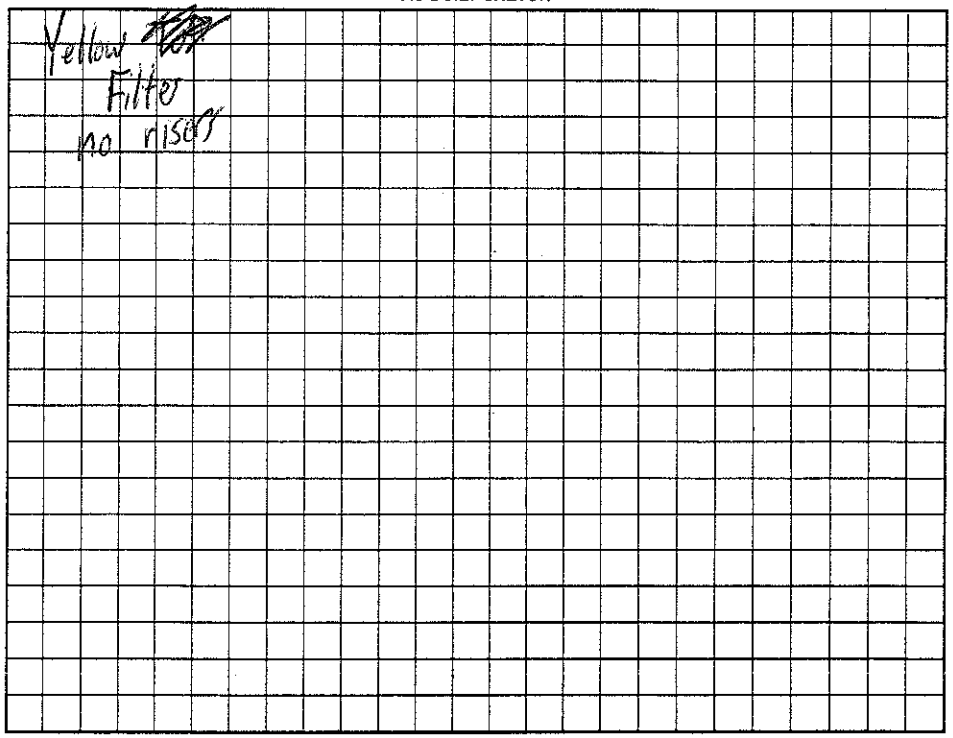

Permit can be suspended or revoked if any false information is supplied toward securing the permit/any unauthorized changes are made to the site/any unauthorized changes are made in the installation of the system. Improvement Permit with plat valid without expiration. Improvement Permit with site plan valid for sixty months. Authorization to Construct is valid for a period equal to that of Improvement Permit – not to exceed sixty months.

Signed: Roy Johnson date ____ Installed by: Steve Jordan

Improvement Permit by: Judy Melville date 7-12-05 Operation Permit by: Jamie Stewart date 1-26-06

Authorization to Construct by: Judy Melville date 7-12-05 Existing System Inspection by: ____ date ____

HEALTH DEPT. COPY: WHITE OWNER COPY (FINAL): YELLOW OWNER COPY (INITIAL): PINK