IREDELL COUNTY HEALTH DEPARTMENT - *ENVIRONMENTAL HEALTH* ☑ STATESVILLE OFFICE 704-878-5305 ☐ MOORESVILLE OFFICE 704-664-5281

IMPROVEMENT PERMIT / AUTHORIZATION TO CONSTRUCT / OPERATION PERMIT / EXISTING SYSTEM INSPECTION

PERMIT # 167581 PIN # 4747-56-6263 DATE 6-29-11

OWNER Daniel Burdecki APPLICANT: PHONE: Home/Cell # 704-380-4944 Business #

SITE ADDRESS 122 Donsdale OWNER / APPLICANT ADDRESS

SITE DIRECTIONS 21N, (L) Shoemaker Dr. (R) Donsdale Dr., site on (R)

SUBDIVISION Donsdale BLOCK / SECTION LOT # 62 LOT AREA .654 DESIGN FLOW 360 L.T.A.R. 3

Septic Tank Ex Gallons: STB Date

Pump Tank Gallons: P T Date

Pump Make Model Serial #

No. Nitrification Fields: 1 No. Lines 3 Linear Feet 300

Trench Width 3 Max. Trench Bottom Depth 36" Gravel Depth n/a

☐ New System ☐ Repair ☐ Expansion System Type I II (III) IV V VI

System Description: 25% Reduction Gravity

Repair System Description:

Maintenance Agreement Required ☐ YES ☒ NO

☒ GRAVITY ☐ PRESSURE

☒ Residence No. Bedrooms 3

☐ Business No. Persons

☐ Other No. Employees

☐ Slab ☒ Crawl Space

☐ Basement w/plumbing ☐ Basement w/o plumbing

Water Supply

☐ Private


☒ Public

☐ Community

Comments / Conditions

INITIAL SITE SKETCH

AS BUILT SKETCH

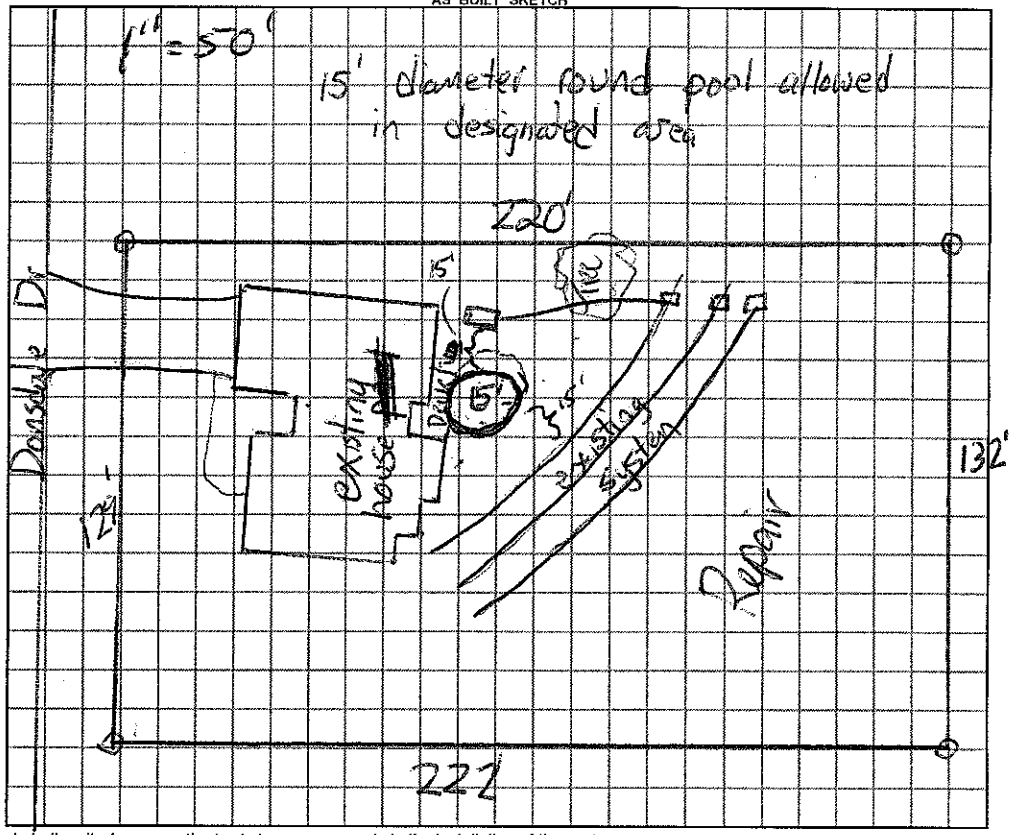

Permit can be suspended or revoked if any false information is supplied toward securing the permit / any unauthorized changes are made to the site / any unauthorized changes are made in the installation of the system.

☐ ***IMPROVEMENT PERMIT*** *with plat valid without expiration.* ☐ ***IMPROVEMENT PERMIT*** *with ~~plat valid without expiration.~~ site plan valid 60 mo.* ☐ ***AUTHORIZATION TO CONSTRUCT*** valid for period equal to IMPROVEMENT PERMIT--not to exceed 60 mo.

Owner / Applicant Signature: Date

IMPROVEMENT PERMIT by: ***REHS*** Date

AUTHORIZATION TO CONSTRUCT by: ***REHS*** Date

YOU SHOULD CONTACT A LOCATOR SERVICE PRIOR TO ANY EXCAVATION

Installed by:

OPERATION PERMIT by: ***REHS*** Date

Existing System Inspected by: ***REHS*** Date 6-29-11

White Copy – Environmental Health YELLOW COPY (Final) Owner / Applicant PINK COPY (Initial) Owner / Applicant