# IREDELL COUNTY HEALTH DEPARTMENT

STATESVILLE 704-878-5305 MOORESVILLE 704-664-5281

## IMPROVEMENT PERMIT / AUTHORIZATION TO CONSTRUCT / OPERATION PERMIT / EXISTING SYSTEM INSPECTION

PERMIT# 122374 PIN# 4747-56-9424 DATE 7/26/04

OWNER OR CONTRACTOR Field Stone Homes LLC PHONE: Business (704)902-4982 Home

ADDRESS 393 River Run Rd Statesville N.C. 28625

LOCATION Hwy 21 N (R) Shumaker Rd (L) Hiking Farm Rd (R) on Donsdale Road 3rd lot on left

SUBDIVISION Donsdale BLOCK / SECTION I LOT 3 LOT AREA .68Ac SITE CLASS P5 DESIGN FLOW 360 L.T.A.R. .25

Septic Tank: 4000 Gallons; STB 1017 Date 1-25-05

Pump Tank: Gallons; PT Date

Pump Make: Model Eaton Serial No.

Nitrification Field: No Fields 1 Square Feet 1440 Linear Feet 360

No Lines 5 Trench Width 36" Max Trench Bottom Depth 30" Gravel Depth 4"

☒ New System ☐ Repair System Type: I, II, III, IV, V, VI

System Description: Gravity, 25% Reduction

Repair System Description: Pump 25% reduction

Maintenance Agreement Required: ☐ Yes ☒ No

☒ House/Mod. Home No. Bedrooms 3

☐ Mobile Home No. Bathrooms —

☐ Business No. Employees

☐ Other


☐ Slab ☒ Crawl Space ☐ Basement w/plumbing ☐ Basement wo/plumbing

Water Supply: ☐ Individual ☒ Public ☐ Community

Comments:/Conditions: ① Install lines on contour ② maintain proper setbacks

Comments:/Conditions: TUFF TITE FILL + MARKER INSTALLER SHOULD ME D/L 10'+ OFF WITH SYSTEM

INITIAL SITE SKETCH 1" = 50ft

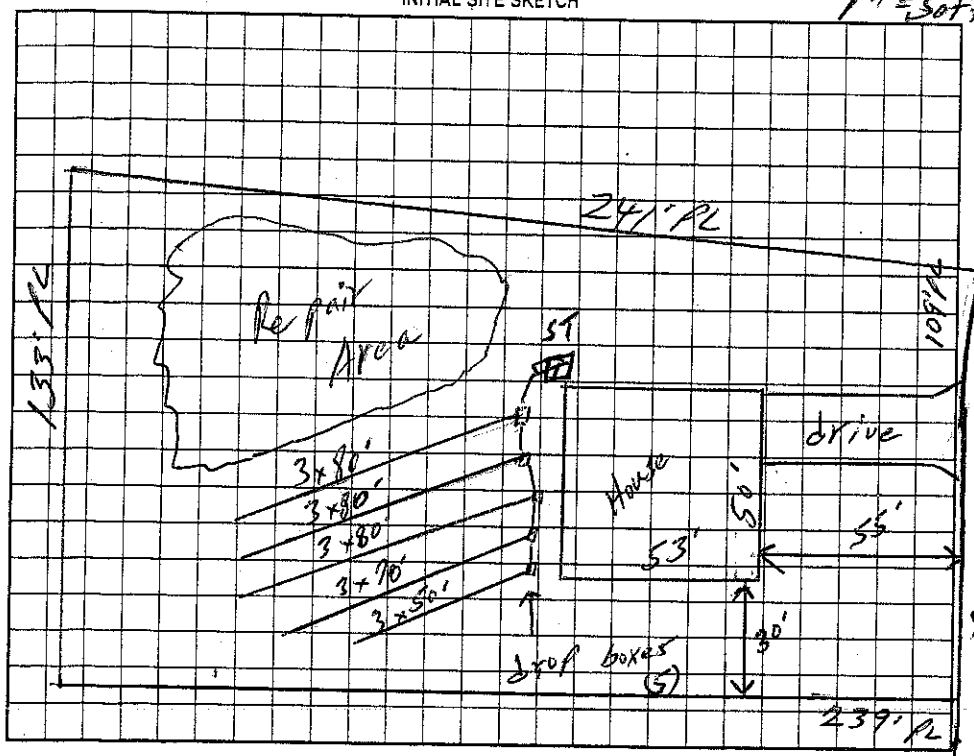


AS BUILT SKETCH

Permit can be suspended or revoked if any false information is supplied toward securing the permit/any unauthorized changes are made to the site/any unauthorized changes are made in the installation of the system. Improvement Permit with plat valid without expiration. Improvement Permit with site plan valid for sixty months. Authorization to Construct is valid for a period equal to that of Improvement Permit – not to exceed sixty months.

Signed: Kevin Hyatt date 8-5-04

Improvement Permit by: William O. Johnson date 7/26/04

Authorization to Construct by: William O. Johnson date 7/26/04

Installed by: Steve Jordan

Operation Permit by: Jan Cook RS date 8-25-05

Existing System Inspection by: date

HEALTH DEPT. COPY: WHITE OWNER COPY (FINAL): YELLOW OWNER COPY (INITIAL): PINK