IREDELL COUNTY HEALTH DEPARTMENT

STATESVILLE 704-878-5305 MOORESVILLE 704-664-5281

IMPROVEMENT PERMIT / AUTHORIZATION TO CONSTRUCT / OPERATION PERMIT / EXISTING SYSTEM INSPECTION

PERMIT# 122374 PIN# 4741-56-9424 DATE 7/26/04

OWNER OR CONTRACTOR Fieldstone Homes LLC PHONE: Business (704)902-4982 Home

ADDRESS 393 River Run Rd Statesville N.C. 28625

LOCATION Hwy 21 N (L) Shumaker Rd (R) Sliding Hill Rd (L) Dow Donsdale Road 3rd Lot on left

SUBDIVISION Donsdale BLOCK / SECTION LOT 3 LOT AREA .68Ac SITE CLASS P5 DESIGN FLOW 360 L.T.A.R. .25

Septic Tank: 4000 Gallons; STB 1012 Date 1-25-05

Pump Tank: Gallons; PT Date

Pump Make: Model Serial No.

Nitrification Field: No Fields 1 Square Feet 1440 Linear Feet 360

No Lines 5 Trench Width 36" Max Trench Bottom Depth 30+ Gravel Depth N/A

☒ New System ☐ Repair System Type: I, II, (III), IV, V, VI

System Description: Gravity, 25% Reduction

Repair System Description: Pump 25% reduction

Maintenance Agreement Required: ☐ Yes ☒ No

☒ House/Mod. Home No. Bedrooms 3

☐ Mobile Home No. Bathrooms —

☐ Business No. Employees —

☐ Other


☐ Slab ☒ Crawl Space ☐ Basement w/plumbing ☐ Basement wo/plumbing

Water Supply: ☐ Individual ☒ Public ☐ Community

Comments:/Conditions: ① Install lines on contour ② maintain proper setbacks

Comments:/Conditions: TUFF TITE F.H. + MARKER INSTALLER SHOULD ME P/L .10' + OFF WITH SYSTEM

INITIAL SITE SKETCH 1" = 50 Ft

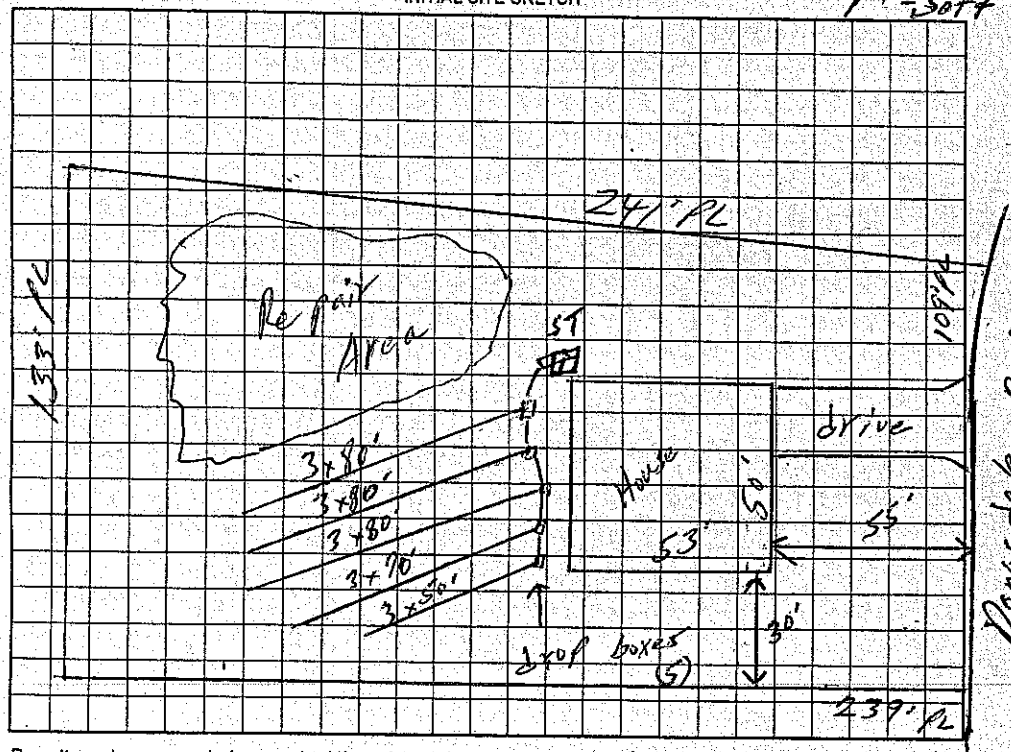

AS BUILT SKETCH

The proposed / (existing) deck to be covered addition does not appear to impact the existing septic system.

**NOTE:

REHS

Date: 6-25-10

ICHD-Environmental Health Division

Permit can be suspended or revoked if any false information is supplied toward securing the permit/any unauthorized changes are made to the site/any unauthorized changes are made in the installation of the system. Improvement Permit with plat valid without expiration. Improvement Permit with site plan valid for sixty months. Authorization to Construct is valid for a period equal to that of Improvement Permit – not to exceed sixty months.

Signed: date 8-5-04

Improvement Permit by: William O. Johnson date 7/26/04

Authorization to Construct by: William O. Johnson date 7/26/04

Installed by: Steve Jordan

Operation Permit by: date 8-25-05

Existing System Inspection by: date

HEALTH DEPT. COPY: WHITE OWNER COPY (FINAL): YELLOW OWNER COPY (INITIAL): PINK