10 Jack Norman 2P-6-11-56 on Linwood

IREDELL COUNTY HEALTH DEPARTMENT

STATESVILLE 704-878-5305 MOORESVILLE 704-664-5281

IMPROVEMENT PERMIT / CERTIFICATE OF COMPLETION / OPERATION PERMIT / EXISTING SYSTEM INSPECTION

PROPERTY DESCRIPTION NO. 19927 DATE 12-21-94 TAX MAP NO. 10 G - A - 18 Pt of Watershed: ☐ Yes ☑ No

OWNER OR CONTRACTOR Ivetell Water Corp PHONE: Business 876-0672 Home

ADDRESS PO Box 711 Statesville

LOCATION 21 N to Jennings Rd 1st business on left

SUBDIVISION BLOCK / SECTION LOT LOT AREA .87 acres SITE CLASS. DESIGN FLOW L.T.A.R.

Septic Tank: Gallons; STB Date
Pump Tank: Gallons; PT Date
Pump Make: Model Serial No.
Nitrification Field: No Fields Square Feet Linear Feet
No Lines Trench Width Max Trench Bottom Depth Gravel Depth

☐ New System ☐ Repair System Type: I, II, III, IV, V, VI
System Description:
Repair System Description:
Maintenance Agreement Required: ☐ Yes ☐ No

☐ House/Mod. Home No. Bedrooms
☐ Mobile Home No. Bathrooms
☑ Business No. Employees
☐ Other Adding Shop +
☐ Slab ☐ Crawl Space ☐ Basement w/plumbing ☐ Basement wo/plumbing


Water Supply:
☐ Individual
☐ Community
☐ Public

Comments:

Comments: Storage building
1 bath room
NO additional Employees

INITIAL SITE SKETCH

AS BUILT SKETCH

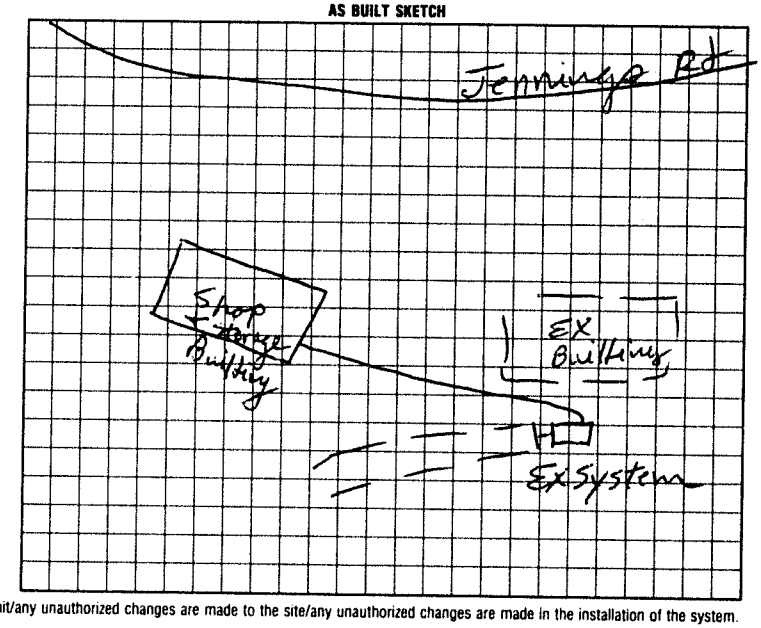

I understand that this permit can be suspended or revoked if any false information is supplied toward securing the permit/any unauthorized changes are made to the site/any unauthorized changes are made in the installation of the system. Improvement Permit is valid for 60 months from date of issuance.

Signed:

Improvement Permit by: date

Existing System Inspection by: R. C. Moore date 12-21-94

Installed by:

Certificate of Completion by: date

Operation Permit by: date

HEALTH DEPT. COPY: WHITE INSPECTION COPY (FINAL): GREEN OWNER COPY (FINAL): YELLOW INSPECTION COPY (INITIAL): PINK OWNER COPY (INITIAL): GOLD