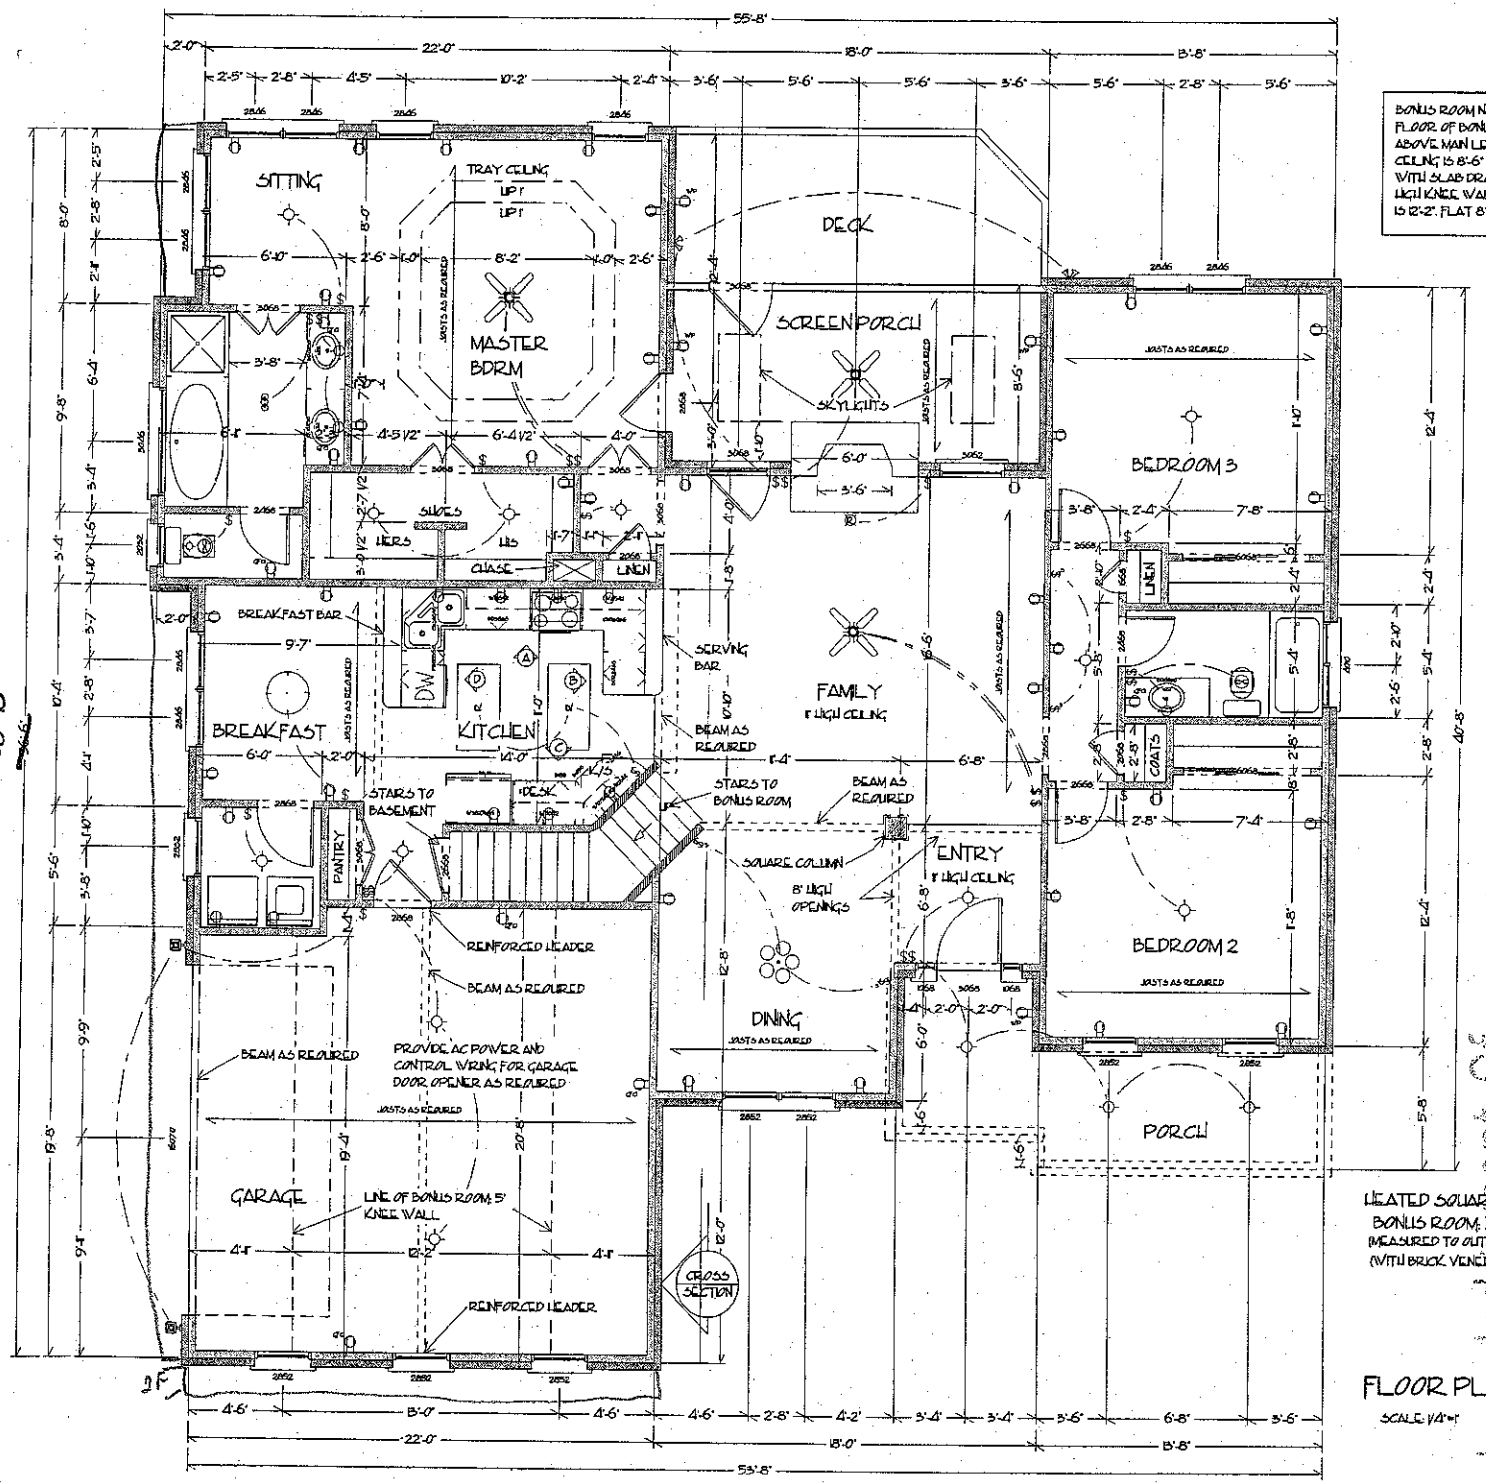


BONUS ROOM NOTES: FINISHED FLOOR OF BONUS ROOM IS 8'-8" ABOVE MAIN LEVEL GARAGE CEILING IS 8'-6" USING 2x10 JOISTS WITH SLAB DROPPED 8" WITH 5' HIGH KNEE WALL INTERIOR WIDTH IS 12'-2". FLAT 8' CEILING IS 5' WIDE.

PLEASE NOTE: THIS PLAN INCLUDES AN OPTIONAL FOUNDATION SHEET. OTHER DRAWINGS MAY NOT REFLECT THE IMPACT OF THIS OPTION.

IF THIS STAMP IS NOT RED IT IS AN ILLEGAL SET OF PLANS

REPRODUCTION OF THESE PLANS BY ANY MEANS IS PROHIBITED BY FEDERAL LAW. VIOLATORS ARE PUNISHABLE BY FINES UP TO $150,000 PER OFFENSE. CALL THE DESIGNER TO OBTAIN LEGAL COPIES OF THIS PLAN.

Council of Residential Home Designers

HEATED SQUARE FOOTAGE: 1787
BONUS ROOM: 265
(MEASURED TO OUTSIDE FRAME WALLS)
(WITH BRICK VENEER: 1853)

FLOOR PLAN
SCALE: 1/4"=1'

Approved as Submitted
Approved as Noted
Do Not Resubmit
Date 11-26-06
Date 9-26-06

All plans are copyrighted by Atlanta Plan Source, Inc. and/or Designer. Reproduction of this exclusive property in any form or medium without express written permission is prohibited. Atlanta Plan Source, Inc. assumes no responsibility for the actual construction and workmanship of the actual residence in local building code requirements and other local ordinances of the respective jurisdictions. Atlanta Plan Source, Inc. assumes no responsibility for any damages, including but not limited to, consequential damages arising out of or in connection with the use of these plans. Atlanta Plan Source, Inc. shall be a party of the purchase price of the home plans. These home plans are prepared for general use only and are not prepared for any specific site. It is the responsibility of the purchaser of these plans, and not of Atlanta Plan Source, Inc., to have a licensed architect, engineer or designer of your choice review and check the plans for compliance with your specific site conditions, state and local codes. Any changes made to these plans may require the plans to comply with seismic, wind, or other special conditions as required by local building codes.

Atlanta PLAN SOURCE INCORPORATED
P.O. Box 1163
Alpharetta, GA 30009
Ph: 770-360-1414

DO NOT COPY WITHOUT WRITTEN COPYRIGHT RELEASE!

A|D B|D

08/05/2006 Copyright, Atlanta Plan Source, Inc. Plan #1717 Crawl