IREDELL COUNTY HEALTH DEPARTMENT

This permit voids previously issues permit dated 7-13-99

STATESVILLE 704-878-5305 (C) MOORESVILLE 704-664-5281

IMPROVEMENT PERMIT / AUTHORIZATION TO CONSTRUCT / OPERATION PERMIT / EXISTING SYSTEM INSPECTION

PERMIT# 079726 PIN# 4747-63-~~3166~~ 1917 DATE 6/8/04

OWNER OR CONTRACTOR W+W Sales INC PHONE: Business – Home (704) 876-6683

ADDRESS P.O. Box 5192 Statesville, N.C. 28687

LOCATION Hwy 21 N. (L) Shumaker Rd turns into White Farm Rd (R) Saddlewood Lane, lot on Right

SUBDIVISION Saddlewood BLOCK / SECTION ____ LOT 17 LOT AREA .54 Acres SITE CLASS. P5 DESIGN FLOW 360 L.T.A.R. .3

Septic Tank: 4000 Gallons; STB 1012 Date 6-10-04

Pump Tank: ____ Gallons; PT ____ Date ____

Pump Make: ____ Model ____ Serial No. ____

Nitrification Field: No Fields 1 Square Feet Equiv to 1200 Linear Feet 300

No Lines ~~Six~~ 5 Trench Width 36" Max Trench Bottom Depth 36" Gravel Depth N/A

[X] New System [ ] Repair System Type: I, II, (III), IV, V, VI

System Description: Gravity, 25% Reduction

Repair System Description: Pump, Panel Block

Maintenance Agreement Required: [ ] Yes [X] No

[X] House/Mod. Home No. Bedrooms 3

[ ] Mobile Home No. Bathrooms 2

[ ] Business No. Employees ____

[ ] Other ____


[ ] Slab [X] Crawl Space [ ] Basement w/plumbing [ ] Basement wo/plumbing

Water Supply: [ ] Individual [X] Public [ ] Community


Comments:/Conditions:

Comments:/Conditions: (1) SYSTEM ALTERED TO FIVE LINES AS SHOWN SYSTEM INSTALLED DEEP (2) SEPTIC TANK WITH RISERS INSTALLED USING "TUFFITE" FILLER

INITIAL SITE SKETCH Scale 1" = 50ft

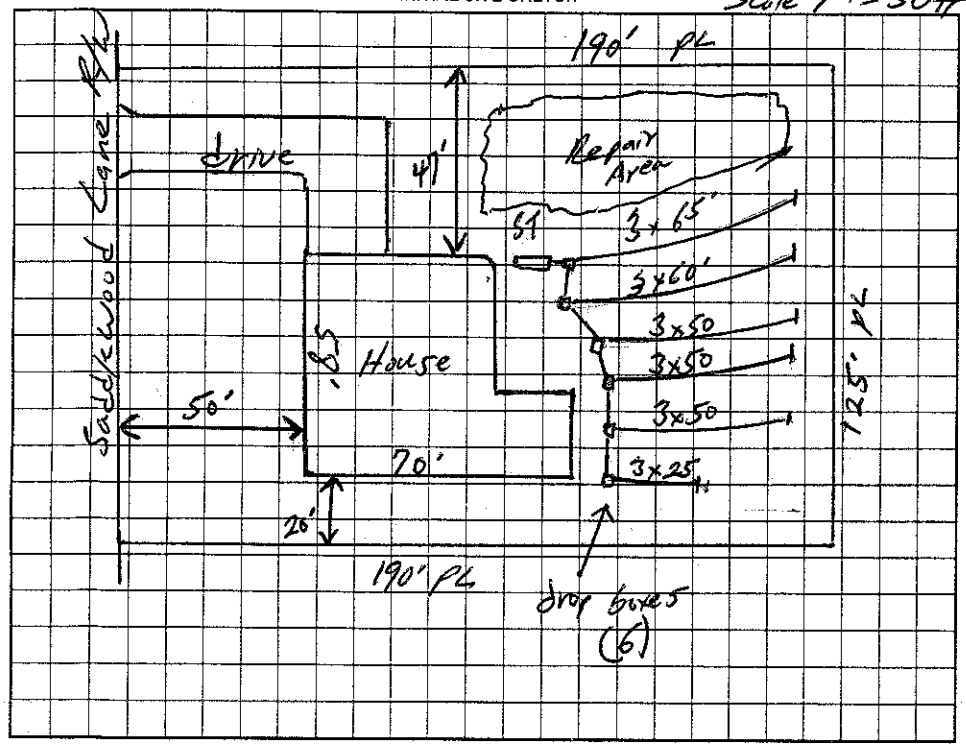

AS BUILT SKETCH

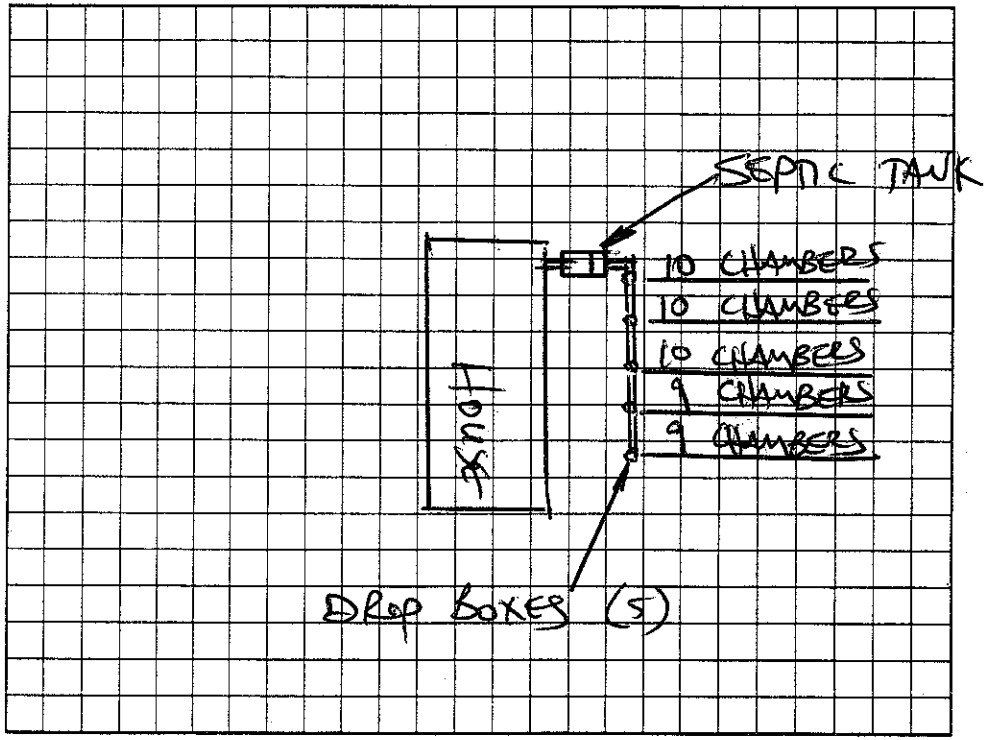

Permit can be suspended or revoked if any false information is supplied toward securing the permit/any unauthorized changes are made to the site/any unauthorized changes are made in the installation of the system. Improvement Permit with plat valid without expiration. Improvement Permit with site plan valid for sixty months. Authorization to Construct is valid for a period equal to that of Improvement Permit – not to exceed sixty months.

Signed: [signature] date 6-10-04 Installed by: PIEDMONT BACKHOE

Improvement Permit by: William O. Johnson date 6/8/04 Operation Permit by: STEVE HENDRICK date 7-1-04

Authorization to Construct by: William O. Johnson date 6/8/04 Existing System Inspection by: ____ date ____

HEALTH DEPT. COPY: WHITE OWNER COPY (FINAL): YELLOW OWNER COPY (INITIAL): PINK