IREDELL COUNTY HEALTH DEPARTMENT

STATESVILLE 704-878-5305 MOORESVILLE 704-664-5281

IMPROVEMENT PERMIT / AUTHORIZATION TO CONSTRUCT / OPERATION PERMIT / EXISTING SYSTEM INSPECTION

PERMIT# 079775 PIN# 4747549142 (pt.) DATE July 13, '99

OWNER OR CONTRACTOR Mike Gaither PHONE: Business 871-7295 Home

ADDRESS 300 Marshall Farm Rd. Harmony 28634

LOCATION 21 N. TL Jennings Rd. TL Whites Farm Rd. TL Saddlewood Lane on Right

SUBDIVISION Saddlewood BLOCK / SECTION LOT 16 LOT AREA 125'x190' SITE CLASS PS DESIGN FLOW 360gpd L.T.A.R. .3

Septic Tank: 1000 Gallons; STB 1012 Date 10 23 99

Pump Tank: Gallons; PT Date

Pump Make: Model Serial No

Nitrification Field: No Fields 1 Square Feet 1200 Linear Feet 400

No Lines 5@80' Trench Width 36" Max Trench Bottom Depth ±20'

☑ New System ☐ Repair System Type: I. II. III. IV. V. VI

System Description: GRAVITY CONVENTIONAL

Repair System Description: GRAVITY/pumped INNOVATIVE

Maintenance Agreement Required: ☐ Yes ☑ No

Gravel Depth 12" ☐ Slab ☑ Crawl Space ☐ Basement w/plumbing ☐ Basement wo/plumbing

☑ House/Mod. Home No. Bedrooms 3

☐ Mobile Home No. Bathrooms 2

☐ Business No. Employees


☐ Other

Water Supply: ☐ Individual ☑ Public ☐ Community


Comments/Conditions: Formerly Lot #18

Comments/Conditions Top Line deep
Home FARTHER BACK THAN original permit
REPAIR will possibly Require 50% Reduction

1"=50' INITIAL SITE SKETCH

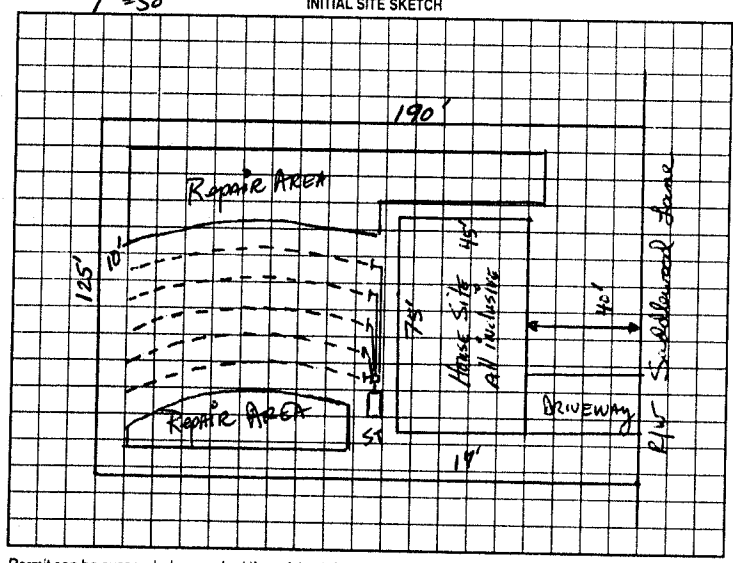

AS BUILT SKETCH

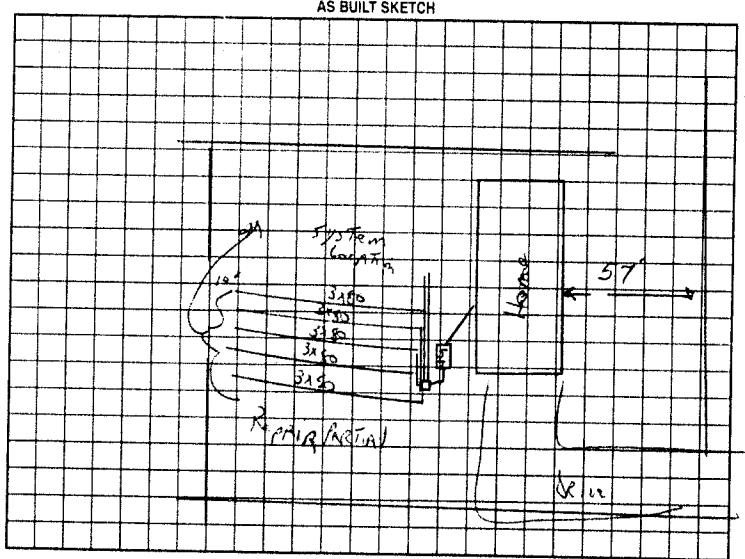

Permit can be suspended or revoked if any false information is supplied toward securing the permit/any unauthorized changes are made to the site/any unauthorized changes are made in the installation of the system. Improvement Permit with plat valid without expiration. Improvement Permit with site plan valid for sixty months. Authorization to Construct is valid for a period equal to that of Improvement Permit – not to exceed sixty months.

Signed: Mike Gaither

Improvement Permit by: Daniel Rittmoon, RS date 7-13-99

Authorization to Construct by: E. C. Moore date 10-5-99

Installed by: CRAIG Thompson GRADING

Operation Permit by: C. Potter date MARCH 29 2000

Existing System Inspection by: date

HEALTH DEPT COPY: WHITE OWNER COPY (FINAL): YELLOW OWNER COPY (INITIAL): PINK