IREDELL COUNTY HEALTH DEPARTMENT

STATESVILLE 704-878-5305 MOORESVILLE 704-664-5281

IMPROVEMENT PERMIT / AUTHORIZATION TO CONSTRUCT / OPERATION PERMIT / EXISTING SYSTEM INSPECTION

PERMIT# 092674 PIN# 4747 63 1628 DATE October 27, 00

OWNER OR CONTRACTOR Robert & Stephanie Wright PHONE: Business 924-4089 Home

ADDRESS 5137 Wilkesboro Hwy, Statesville 28625

LOCATION 21 N. TL Jennings Rd. TL White's Farm RD TL Saddlewood TR Appaloosa on left NEAR END

SUBDIVISION Saddlewood BLOCK / SECTION II LOT 29 LOT AREA 155'x185' SITE CLASS PS DESIGN FLOW 360gpd L.T.A.R. .3

Septic Tank: 1000 Gallons: STB 1012 Date 3-19-01
Pump Tank: 1000 Gallons: P.T. Date 8-31-00
Pump Make: Hydromatic Model K50AL Serial No 51654-0121
Nitrification Field: No Fields 1 Square Feet 1200 Linear Feet 400
No Lines 4 Trench Width 36" Max Trench Bottom Depth 36" Gravel Depth 12"

☑ New System ☐ Repair System Type: I, II, III, IV, V, VI
System Description: PM - CONVENTIONAL
Repair System Description: PM - INNOVATIVE
Maintenance Agreement Required: ☐ Yes ☑ No

☑ House/Mod. Home No. Bedrooms 3
☐ Mobile Home No. Bathrooms 2
☐ Business No. Employees
☐ Other


☐ Slab ☑ Crawl Space ☐ Basement w/plumbing ☐ Basement wo/plumbing

Water Supply: ☐ Individual ☑ Public ☐ Community

Comments/Conditions: OWNER desires to have initial system in backyard. Do not cut/grade septic system AREA.

Comments/Conditions: -Pebble Filter
-Septic Tank Risers Installed
- Pressure Manifold Check Okay
-Electrical + Alarm Check → 6/21/01 MR

INITIAL SITE SKETCH 1"=50'

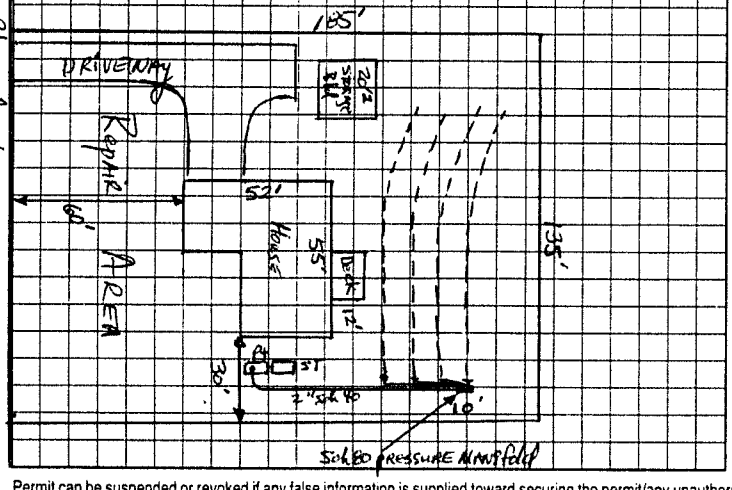

AS BUILT SKETCH

Installed as Shown per Initial Site Sketch

Permit can be suspended or revoked if any false information is supplied toward securing the permit/any unauthorized changes are made to the site/any unauthorized changes are made in the installation of the system. Improvement Permit with plat valid without expiration. Improvement Permit with site plan valid for sixty months. Authorization to Construct is valid for a period equal to that of Improvement Permit – not to exceed sixty months.

Signed: Stephanie Wright date 10-27-00
Improvement Permit by: [signature] RS date 10-27-00
Authorization to Construct by: [signature] RS date 10.27-00

Installed by: A-1 Backhoe
Operation Permit by: William O. Johnson date 6/21/01
Existing System Inspection by: date

HEALTH DEPT. COPY: WHITE OWNER COPY (FINAL): YELLOW OWNER COPY (INITIAL): PINK