IREDELL COUNTY HEALTH DEPARTMENT

STATESVILLE 704-878-5305 MOORESVILLE 704-664-5281

IMPROVEMENT PERMIT / AUTHORIZATION TO CONSTRUCT / OPERATION PERMIT / EXISTING SYSTEM INSPECTION

PERMIT # 157440 PIN # 4747-04-0987 DATE 23 Jul 09

OWNER or APPLICANT Jeffrey F. Jones PHONE: Business (704) 902-2772 Home:

OWNER or APPLICANT ADDRESS 131 Harper Ridge Ln. Statesville, N.C.

LOCATION / DIRECTIONS Jennings Rd. Turn onto Wilkins Farm Rd. TL Donsdale TL Stallions - 4th lot on Rt,

SUBDIVISION Donsdale BLOCK / SECTION II LOT # 23 LOT AREA 0.594 ac. DESIGN FLOW 360 gpd L.T.A.R. 0.3 gpd/ft²/d

Septic Tank 1000 Gallons: STB 1012 Date 4-15-08
Pump Tank Gallons: P T Date
Pump Make Model Serial #
Nitrification Field No Fields 1 No Lines 4 Linear Feet 300
Trench Width 36" Max. Trench Bottom Depth 36" Gravel Depth NA

☑ New System ☐ Repair ☐ Expansion System Type I II (III) IV V VI
System Description: 25% Reduction
Repair System Description: 25% Reduction
Maintenance Agreement Required ☐ YES ☒ NO
☑ GRAVITY ☐ PRESSURE

☑ Residence No. Bedrooms 3
☐ Business No. Persons
☐ Other No. Employees
☐ Slab ☑ Crawl Space
☐ Basement w/plumbing ☐ Basement w/o plumbing

Water Supply: ☐ Private ☑ Public ☐ Community

Comments / Conditions
* Follow contour / Honor all setback requirements

Comments / Conditions
endcap distribution

INITIAL SITE SKETCH

* Please see Attached Site Sketch

AS BUILT SKETCH

Red Filter

Permit can be suspended or revoked if any false information is supplied toward securing the permit / any unauthorized changes are made to the site / any unauthorized changes are made in the installation of the system.

☐ *IMPROVEMENT PERMIT w / plat valid without expiration.* ☑ *IMPROVEMENT PERMIT w / site plan valid for 60 mos.* ☑ *AUTHORIZATION TO CONSTRUCT valid for period equal to IMPROVEMENT PERMIT-not to exceed 60 mo.*

Owner / Applicant Signature: Date 7/23/09

Improvement Permit by: , R.S. Date 23 Jul 09

Authorization to Construct by: , R.S. Date 23 Jul 09

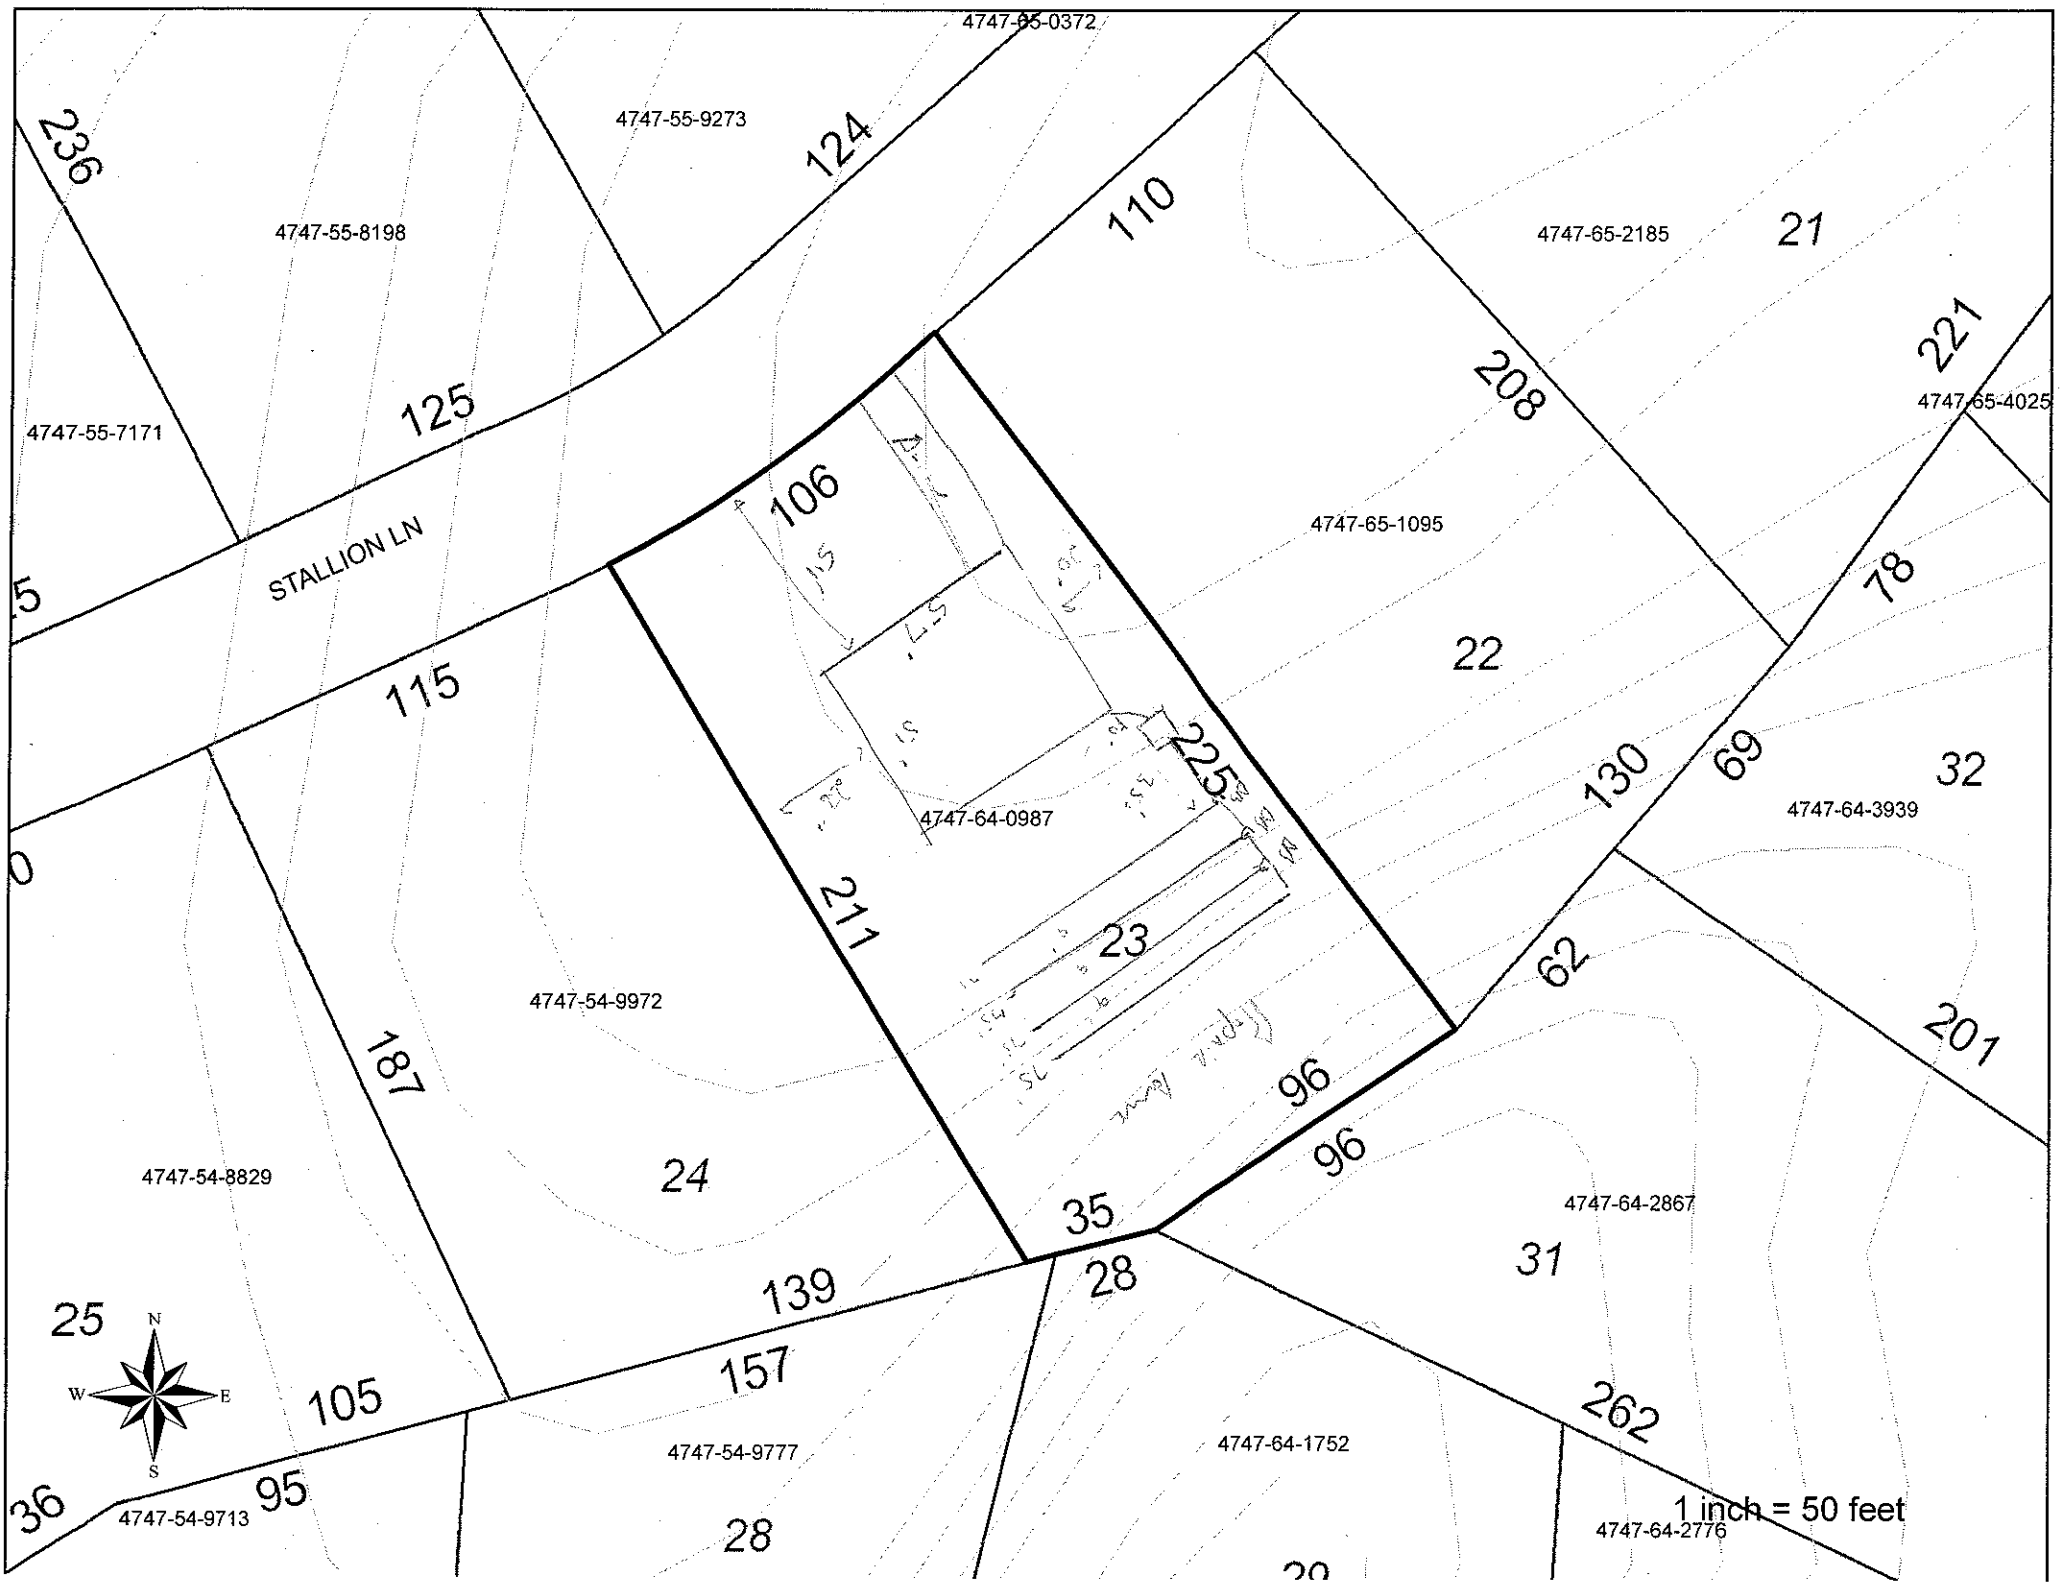
YOU SHOULD CONTACT A LOCATOR SERVICE PRIOR TO ANY EXCAVATION.

Installed by: Craig Thompson

Operation Permit by: Date: 9-14-09

Existing System Inspected by: Date:

WHITE COPY Environmental Health YELLOW COPY (Final) Owner / Applicant PINK COPY (Initial) Owner / Applicant


4747-55-0372
4747-55-9273
4747-55-8198
4747-55-7171
4747-65-2185
4747-65-4025
4747-65-1095
4747-64-0987
4747-64-3939
4747-54-9972
4747-54-8829
4747-64-2867
4747-54-9777
4747-64-1752
4747-54-9713
4747-64-2776
STALLION LN
236
124
110
125
208
221
106
115
225
78
69
130
32
211
62
201
187
96
96
35
28
139
157
105
95
262
36
25
21
22
23
24
31
28
N
W
E
S
1 inch = 50 feet