IREDELL COUNTY HEALTH DEPARTMENT

This permit voids previously issued permit dated 6/25/99.

STATESVILLE 704-878-5305 (1) MOORESVILLE 704-664-5281

IMPROVEMENT PERMIT / AUTHORIZATION TO CONSTRUCT / OPERATION PERMIT / EXISTING SYSTEM INSPECTION

PERMIT# 079765 PIN# 4747-64-1230 DATE 5/22/03

OWNER OR CONTRACTOR K.W. Nicholson PHONE: Business (704) 902-0799 Home —

ADDRESS 182 Millstone Drive Statesville N.C. 28677

LOCATION Hwy 21 N. @ Shumaker Road @ Saddlewood Lane 1st on left (#6)

SUBDIVISION Saddlewood BLOCK / SECTION — LOT 6 LOT AREA .54 Ac SITE CLASS. P5 DESIGN FLOW 360 L.T.A.R. .30

Septic Tank: 4000 Gallons; STB 1012 Date 4-27-03

Pump Tank: Gallons; PT Date

Pump Make: Model Serial No.

Nitrification Field: No Fields 1 Square Feet Equiv to 1200 Linear Feet 300

No Lines 5@ 60' Trench Width 36" Max Trench Bottom Depth 36" Gravel Depth N/A

☒ New System ☐ Repair System Type: I, II, III, IV, V, VI (V)

System Description: Gravity 25% Reduction

Repair System Description: LP Panel Block

Maintenance Agreement Required: ☐ Yes ☒ No

☒ House/Mod. Home ☐ Mobile Home ☐ Business ☐ Other

No. Bedrooms 3 No. Bathrooms 2 No. Employees


☐ Slab ☒ Crawl Space ☐ Basement w/plumbing ☐ Basement wo/plumbing

Water Supply: ☒ Individual ☐ Public ☐ Community

Comments:/Conditions: Formerly lot #8
New House Plans okay - 5/29/03,
-HD approval to use drop boxes

Comments:/Conditions: -Tuff Tite Filter + ST marker Installed
SYSTEM INSTALLED FOLLOWING PERIOD of WET WEATHER

INITIAL SITE SKETCH 1" = 50'

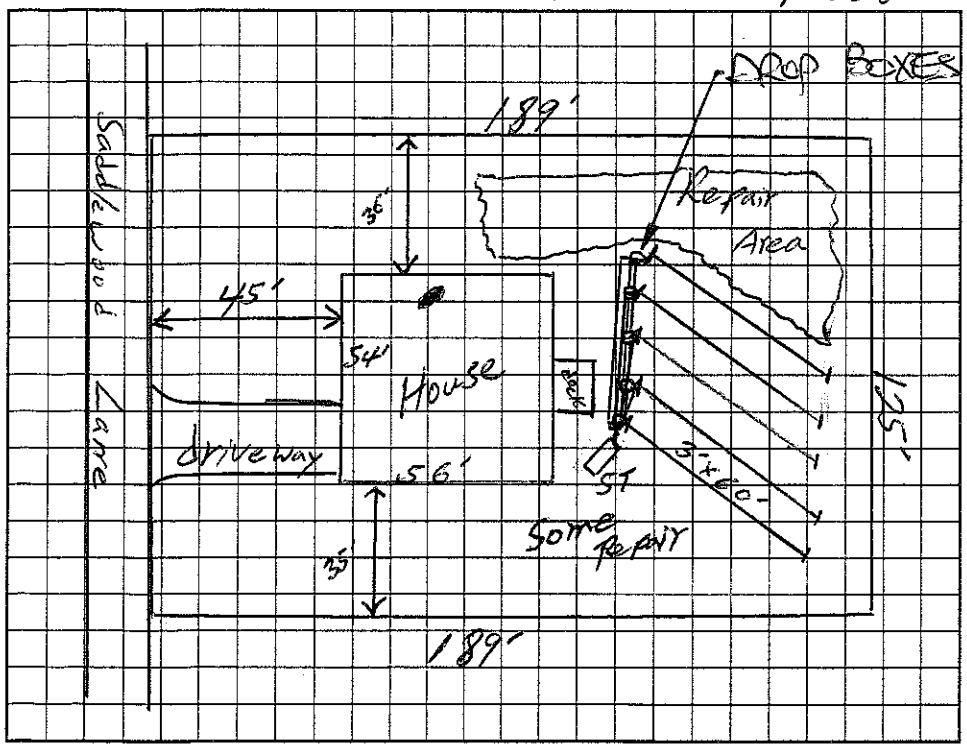

AS BUILT SKETCH

SYSTEM INSTALLED ACCORDING TO INITIAL SITE SKETCH

Permit can be suspended or revoked if any false information is supplied toward securing the permit/any unauthorized changes are made to the site/any unauthorized changes are made in the installation of the system. Improvement Permit with plat valid without expiration. Improvement Permit with site plan valid for sixty months. Authorization to Construct is valid for a period equal to that of Improvement Permit – not to exceed sixty months.

Signed: [redacted] date 5-23-03

Improvement Permit by: William O. Johnson date 5/22/03

Authorization to Construct by: William O. Johnson date 5/22/03

Installed by: DAVID YOUNTZ

Operation Permit by: STEVE HEDRICK date 11-7-03

Existing System Inspection by: date

HEALTH DEPT. COPY: WHITE OWNER COPY (FINAL): YELLOW OWNER COPY (INITIAL): PINK