Post & 9/19/01 wf

IREDELL COUNTY HEALTH DEPARTMENT

STATESVILLE 704-878-5305 MOORESVILLE 704-664-5281

IMPROVEMENT PERMIT / AUTHORIZATION TO CONSTRUCT / OPERATION PERMIT / EXISTING SYSTEM INSPECTION

PERMIT# 095045 PIN# 4747642159 DATE 3/15/01

OWNER OR CONTRACTOR R+L Constructors PHONE: Business (704) 880-8219 Home

ADDRESS 289 Sharon School Road Statesville, NC 28677

LOCATION Hwy 21 N. Whites Farm Road, R on Saddlewood, Lot on left

SUBDIVISION Saddlewood BLOCK / SECTION #1 LOT 7 LOT AREA .54 Ac SITE CLASS PS DESIGN FLOW 360 L.T.A.R. .35

Septic Tank: 1000 Gallons: STB Date

Pump Tank: Gallons: PT Date

Pump Make: Model Serial No

Nitrification Field: No Fields 1 Square Feet 1029 Linear Feet 343

No Lines 5@70' Trench Width 36" Max Trench Bottom Depth 30"

X New System ☐ Repair System Type: (I) II, IV, V, VI

System Description: Gravity Conventional

Repair System Description: Pump, 3 Bdrm Reduction

Maintenance Agreement Required: ☐ Yes X No

X House/Mod. Home ☐ Mobile Home ☐ Business ☐ Other

No. Bedrooms 3 No. Bathrooms 2 No. Employees


Water Supply: ☐ Individual X Public ☐ Community

Gravel Depth 12" ☐ Slab X Crawl Space ☐ Basement w/plumbing ☐ Basement wo/plumbing

Comments/Conditions: ① Keep Septic System 10ft from property lines ② Install lines on contour

Comments/Conditions:
- Poly lok Filter Installed
- Septic Tank risers Installed

INITIAL SITE SKETCH 1" = 40'

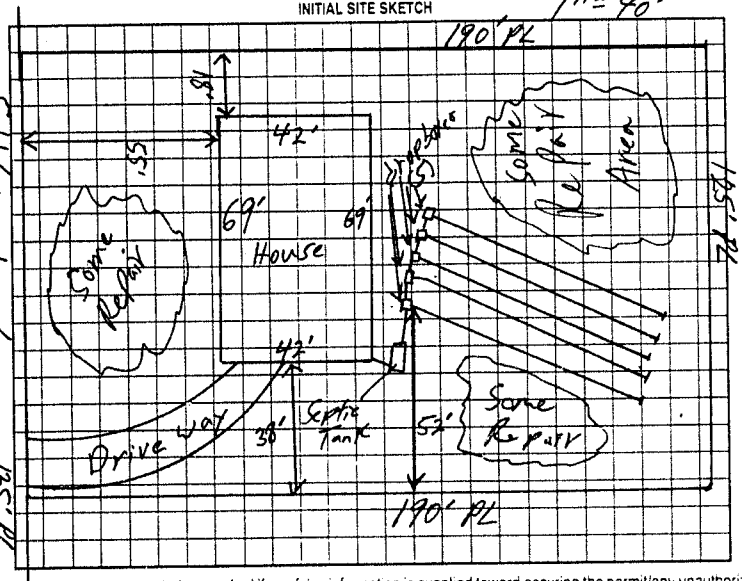

AS BUILT SKETCH

Installed as Shown Per Initial Site Sketch

Permit can be suspended or revoked if any false information is supplied toward securing the permit/any unauthorized changes are made to the site/any unauthorized changes are made in the installation of the system. Improvement Permit with plat valid without expiration. Improvement Permit with site plan valid for sixty months. Authorization to Construct is valid for a period equal to that of Improvement Permit – not to exceed sixty months.

Signed: David R. Wilson date 3-21-01

Improvement Permit by: William O. Johnson, RSI date 3/15/01

Authorization to Construct by: William O. Johnson, RSI date 3/15/01

Installed by: Steve Jordan

Operation Permit by: William O. Johnson date 9/13/01

Existing System Inspection by: date

HEALTH DEPT COPY WHITE OWNER COPY (FINAL) YELLOW OWNER COPY (INITIAL) PINK