2.30

CJ

IREDELL COUNTY HEALTH DEPARTMENT

STATESVILLE 704-878-5305 MOORESVILLE 704-664-5281

IMPROVEMENT PERMIT / AUTHORIZATION TO CONSTRUCT / OPERATION PERMIT / EXISTING SYSTEM INSPECTION

PERMIT# 143521 PIN# 4747642455 DATE 7-13-07

OWNER OR APPLICANT Terrance Hamby PHONE: Business 704 682-4419 Home

ADDRESS 124 Cherry Street Statesville NC 28677

LOCATION 21 N to Jennings Rd (L) Whitestown, (L) Dondale Property on right

SUBDIVISION Dondale BLOCK / SECTION TL LOT 47 LOT AREA .55 SITE CLASS. RSO DESIGN FLOW 360 L.T.A.R. 3

Septic Tank: 1000 Gallons; STB 1000 Date

Pump Tank: Gallons; PT Date

Pump Make: Model Serial No.

Nitrification Field: No Fields Square Feet 1250 Linear Feet 300

No Lines 4 Trench Width 36" Max Trench Bottom Depth 36 Gravel Depth

☑ New System ☐ Repair ☐ Expansion System Type: I (II) IV V VI

System Description: 25% Reduct

Repair System Description: 25% Reduct

Maintenance Agreement Required: ☐ Yes ☐ No

☑ House/Mod. Home No. Bedrooms 3

☐ Mobile Home No. Persons 2

☐ Business No. Employees

☐ Other

Water Supply: ☐ Individual ☑ Public ☐ Community


☑ Gravity ☐ Pressure ☐ Slab ☑ Crawl Space ☐ Basement w/plumbing ☐ Basement wo/plumbing

Comments:/Conditions:


Comments:/Conditions:

Brown Filter

INITIAL SITE SKETCH

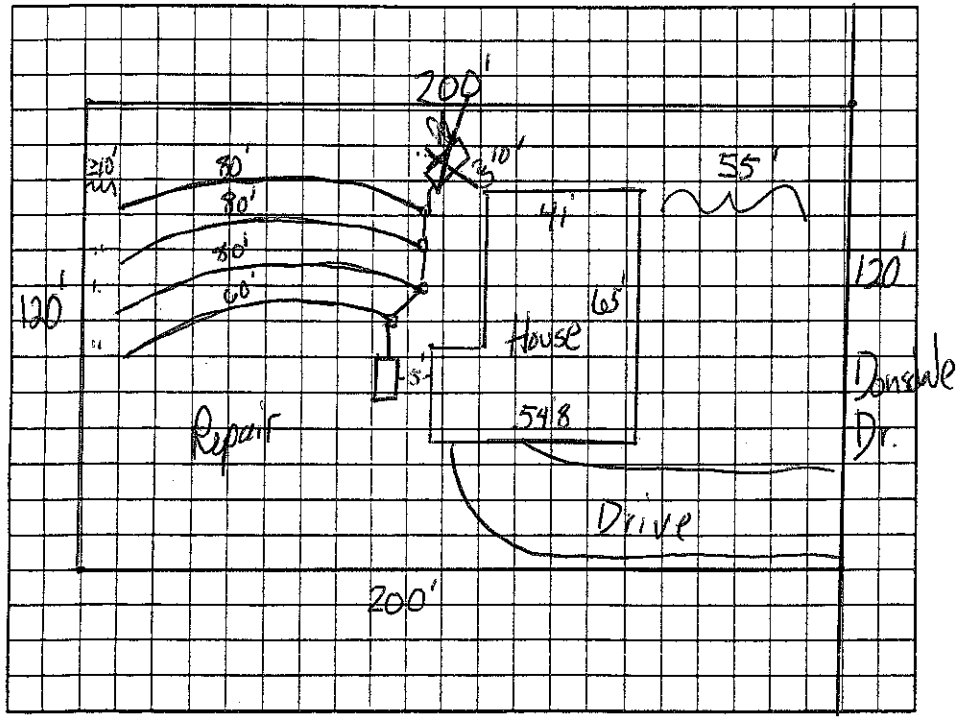

AS BUILT SKETCH

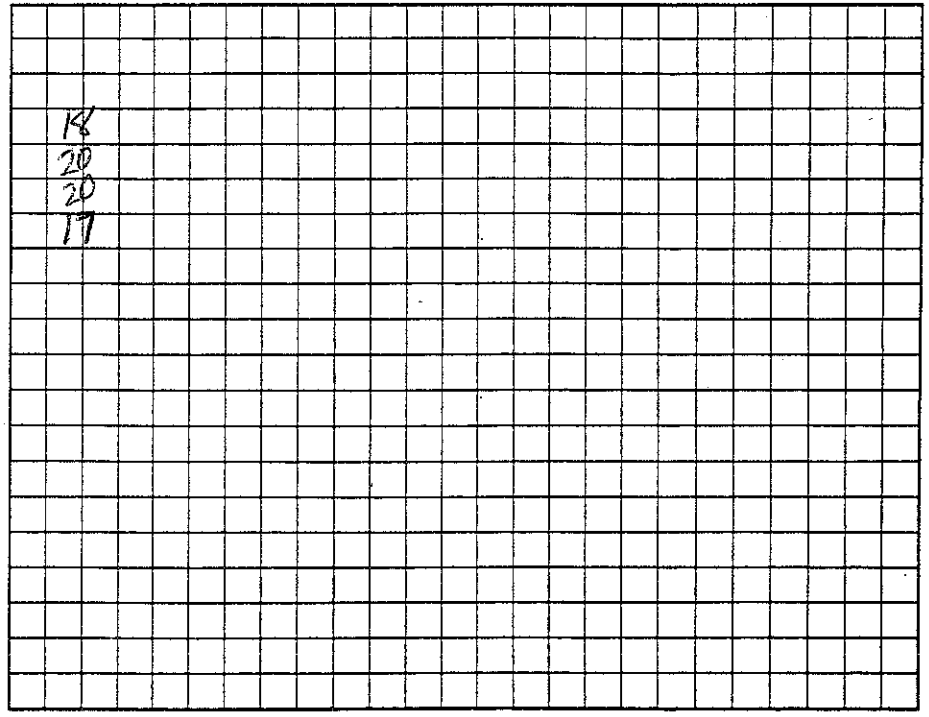

Permit can be suspended or revoked if any false information is supplied toward securing the permit/any unauthorized changes are made to the site/any unauthorized changes are made in the installation of the system. Improvement Permit with plat valid without expiration. ☐ Improvement Permit with site plan valid for sixty months ☐ Authorization to Construct is valid for a period equal to that of Improvement Permit – not to exceed sixty months.

Signed: date 8-08-0

Improvement Permit by: date 7-13-07

Authorization to Construct by: date 7-13-07

Installed by: Cothen & Son

Operation Permit by: date 12-17-07

Existing System Inspection by: date

HEALTH DEPT. COPY: WHITE OWNER COPY (FINAL): YELLOW OWNER COPY (INITIAL): PINK