CI

IREDELL COUNTY HEALTH DEPARTMENT

STATESVILLE 704-878-5305 MOORESVILLE 704-664-5281

IMPROVEMENT PERMIT / AUTHORIZATION TO CONSTRUCT / OPERATION PERMIT / EXISTING SYSTEM INSPECTION

PERMIT# 147406 PIN# 4747644695 DATE 2-7-08

OWNER OR APPLICANT JFJ Custom Homes PHONE: Business 704 902 2772 Home

ADDRESS 104 Houpe Ridge Ln

LOCATION 21 N, (L) on Jonn, Jr Rd, (R) on Wilkes Farm, (L) onto Donsdale Drive, Lot 40 is on left near back of subdivision.

SUBDIVISION Donsdale BLOCK / SECTION 2 LOT 40 LOT AREA .591 Ac. SITE CLASS PS DESIGN FLOW 360 L.T.A.R. .3

Septic Tank: 1000 Gallons; STB 1012 Date 8-23-07

Pump Tank: Gallons; PT Date

Pump Make: Model Serial No.

Nitrification Field. No Fields 1 Square Feet 1200 Linear Feet 300

No Lines 4 Trench Width 36" Max Trench Bottom Depth 36" Gravel Depth ☒ Gravity ☐ Pressure

☒ New System ☐ Repair ☐ Expansion System Type: I II III IV V VI

System Description: 25% Reduction Gravity

Repair System Description: 25% Reduction Gravity

Maintenance Agreement Required: ☐ Yes ☒ No

☒ House/Mod. Home No. Bedrooms 3

☐ Mobile Home No. Persons

☐ Business No. Employees

☐ Other


Water Supply: ☐ Individual ☒ Public ☐ Community

☐ Slab ☒ Crawl Space ☐ Basement w/plumbing ☐ Basement wo/plumbing


Comments:/Conditions:

Comments:/Conditions: TUFFTIL Filter & Marker

INITIAL SITE SKETCH

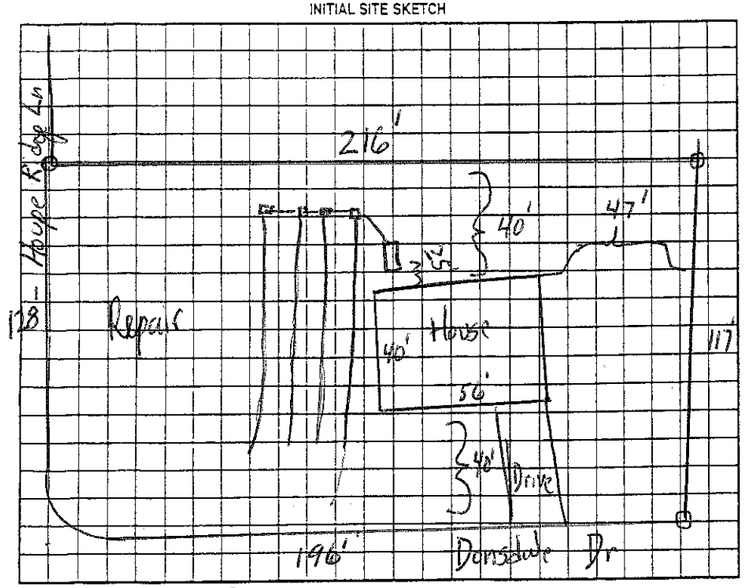

AS BUILT SKETCH

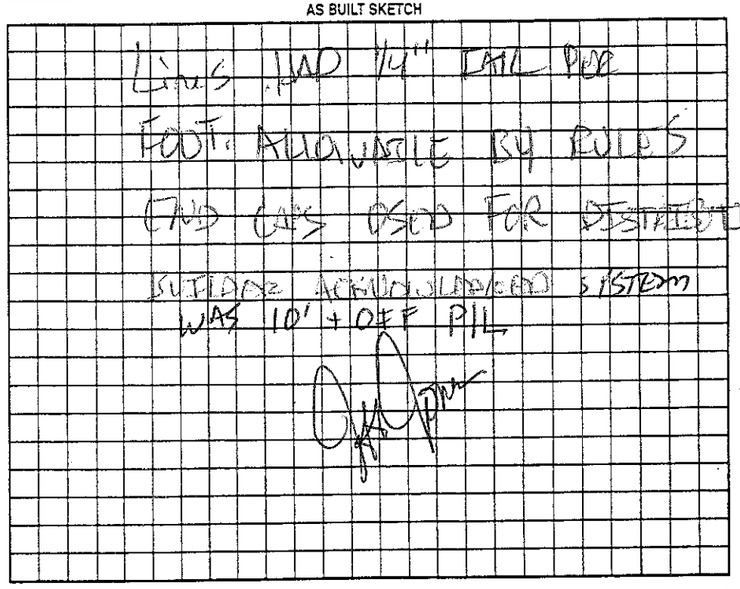

Permit can be suspended or revoked if any false information is supplied toward securing the permit/any unauthorized changes are made to the site/any unauthorized changes are made in the installation of the system. Improvement Permit with plat valid without expiration ☐ Improvement Permit with site plan valid for sixty months ☒ Authorization to Construct is valid for a period equal to that of Improvement Permit – not to exceed sixty months.

Signed: date 2-8-08

Improvement Permit by: date 2-7-08

Authorization to Construct by: date 2-7-08

Installed by: Craig Thomas Gaddis

Operation Permit by: date 4-23-08

Existing System Inspection by: date

HEALTH DEPT. COPY: WHITE OWNER COPY (FINAL): YELLOW OWNER COPY (INITIAL): PINK