IREDELL COUNTY HEALTH DEPARTMENT

STATESVILLE 704-878-5305 MOORESVILLE 704-664-5281

IMPROVEMENT PERMIT / AUTHORIZATION TO CONSTRUCT / OPERATION PERMIT / EXISTING SYSTEM INSPECTION

PERMIT# 079768 PIN# 4747549142 (pt.) DATE June 28, 99

OWNER OR CONTRACTOR Mike Gaither PHONE: Business 871-7295 Home

ADDRESS 300 Marshall Farm Rd. Harmony 28634

LOCATION 21 N. TL Jennings Rd. & TL Whites Farm Rd. TL Saddlewood Lane on left

SUBDIVISION Saddlewood BLOCK / SECTION LOT 9 LOT AREA 125' X 187' SITE CLASS PS DESIGN FLOW 360gpd L.T.A.R. .3

Septic Tank: 1080 Gallons; STB 1012 Date 10-22-99

Pump Tank: Gallons; PT Date

Pump Make: Model Serial No.

Nitrification Field: No Fields 1 Square Feet 1200 Linear Feet 400

No Lines 5 @ 80' Trench Width 36" Max Trench Bottom Depth 36"

☑ New System ☐ Repair System Type: I II III IV V VI

System Description: Gravity Conventional

Repair System Description: LPP/PM Innovative

Maintenance Agreement Required: ☐ Yes ☑ No

Gravel Depth 12" ☐ Slab ☑ Crawl Space ☐ Basement w/plumbing ☐ Basement wo/plumbing

☑ House/Mod. Home No. Bedrooms 3

☐ Mobile Home No. Bathrooms 2

☐ Business No. Employees


☐ Other

Water Supply: ☐ Individual ☑ Public ☐ Community


Comments/Conditions: Formerly Lot # 11

Comments/Conditions

1"=50' INITIAL SITE SKETCH

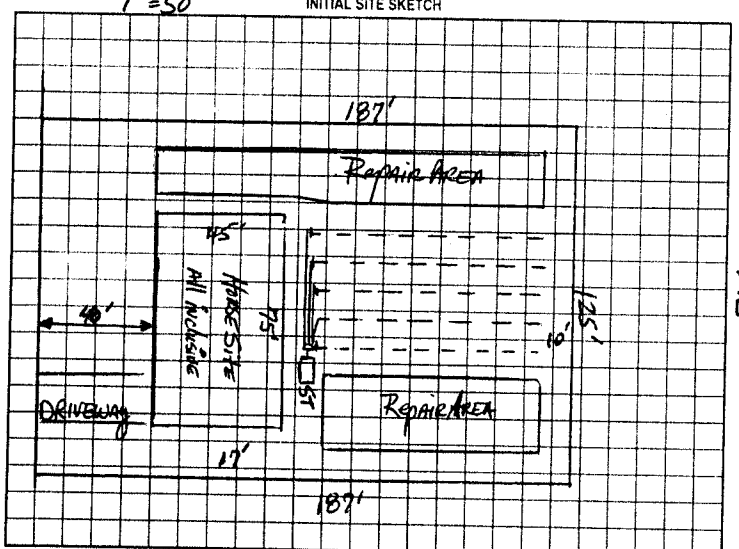

AS BUILT SKETCH

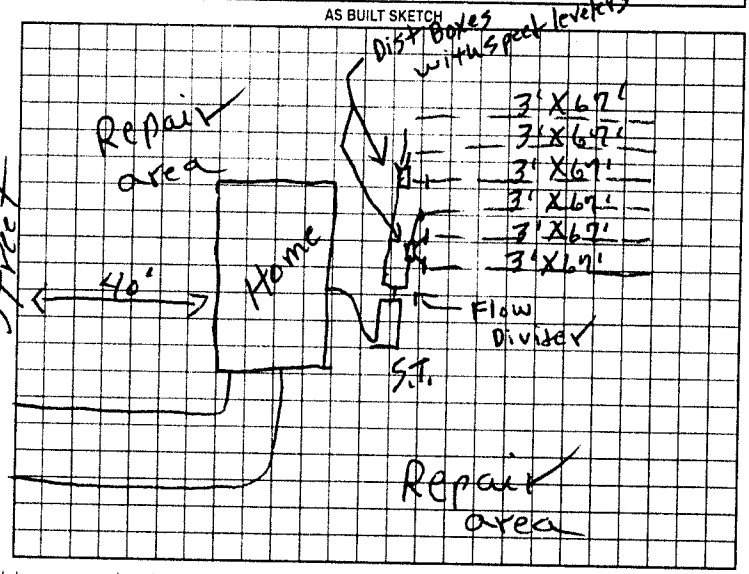

Permit can be suspended or revoked if any false information is supplied toward securing the permit/any unauthorized changes are made to the site/any unauthorized changes are made in the installation of the system. Improvement Permit with plat valid without expiration. Improvement Permit with site plan valid for sixty months. Authorization to Construct is valid for a period equal to that of Improvement Permit – not to exceed sixty months.

Signed: Mike Gaither date

Improvement Permit by: R. C. Moore date 6-28-99

Authorization to Construct by: R. C. Moore date 10-12-99

Installed by: Craig Thompson

Operation Permit by: R. C. Moore date 2-25-00

Existing System Inspection by: date

HEALTH DEPT COPY WHITE OWNER COPY (FINAL) YELLOW OWNER COPY (INITIAL) PINK