# IREDELL COUNTY HEALTH DEPARTMENT

STATESVILLE 704-878-5305 (at) (CE) MOORESVILLE 704-664-5281

## IMPROVEMENT PERMIT / AUTHORIZATION TO CONSTRUCT / OPERATION PERMIT / EXISTING SYSTEM INSPECTION

PERMIT # 156164 PIN # 4747-64-5739 DATE 4-29-09

OWNER or APPLICANT (JFJ Custom Homes) Attn. Don Houpe Jr. PHONE: Business Home: 704 902 2772

OWNER or APPLICANT ADDRESS 112 Houpe Ridge Dr. Dante Donalds

LOCATION / DIRECTIONS 21N, (L) on Jennings Rd, (L) into Houpe Ridge Ln 2nd lot on right

SUBDIVISION Donsdale BLOCK / SECTION 2 LOT # 39 LOT AREA .599 DESIGN FLOW 360 L.T.A.R. .3

Septic Tank 1000 Gallons: STB 760 Date 12-5-08

Pump Tank Gallons: P T Date

Pump Make Model Serial #

Nitrification Field No Fields 1 No Lines 4 Linear Feet 300'

Trench Width 36" Max. Trench Bottom Depth 30" Gravel Depth n/a

☒ New System ☐ Repair ☐ Expansion System Type I II III IV V VI

System Description: 25% Reduction Gravity

Repair System Description: 25% Reduction Gravity

Maintenance Agreement Required ☐ YES ☒ NO

☒ GRAVITY ☐ PRESSURE


☒ Residence No. Bedrooms 3 ☐ Business No. Persons ☐ Other No. Employees ☐ Slab ☒ Crawl Space ☐ Basement w/plumbing ☐ Basement w/o plumbing

Water Supply: ☐ Private ☒ Public ☐ Community

Comments / Conditions


(4) 3' x 75' @ 30" deep

INITIAL SITE SKETCH

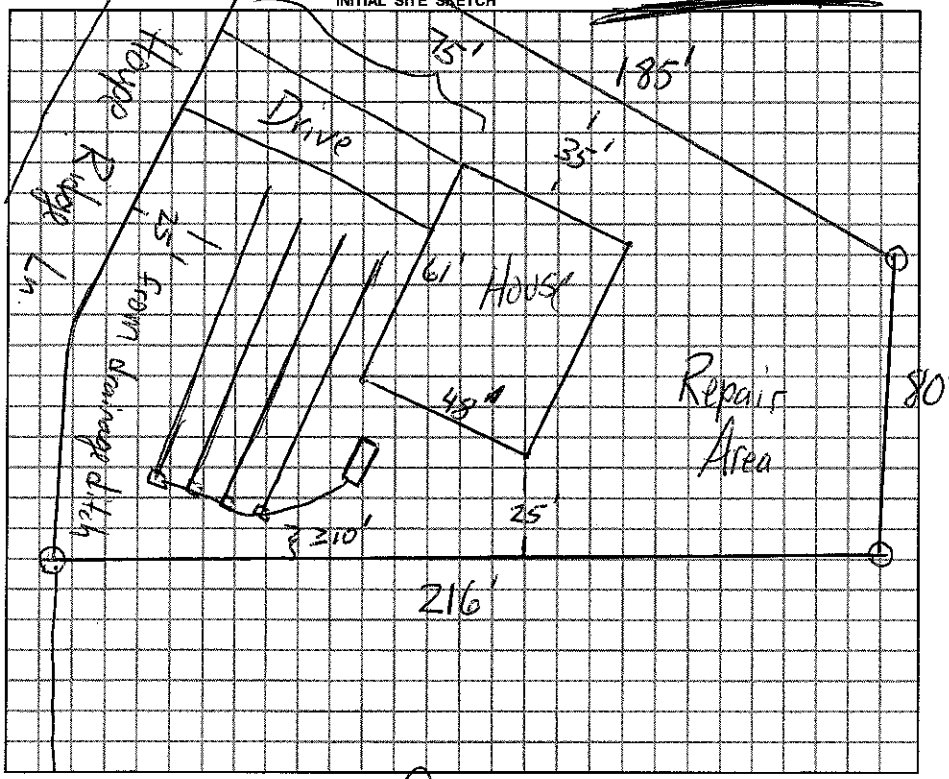


Comments / Conditions System 10'± off marked P/L 24" Deep on Entrance & 30" Deep on Dwy side DRIVEWAY & marker USED END CAPS

AS BUILT SKETCH

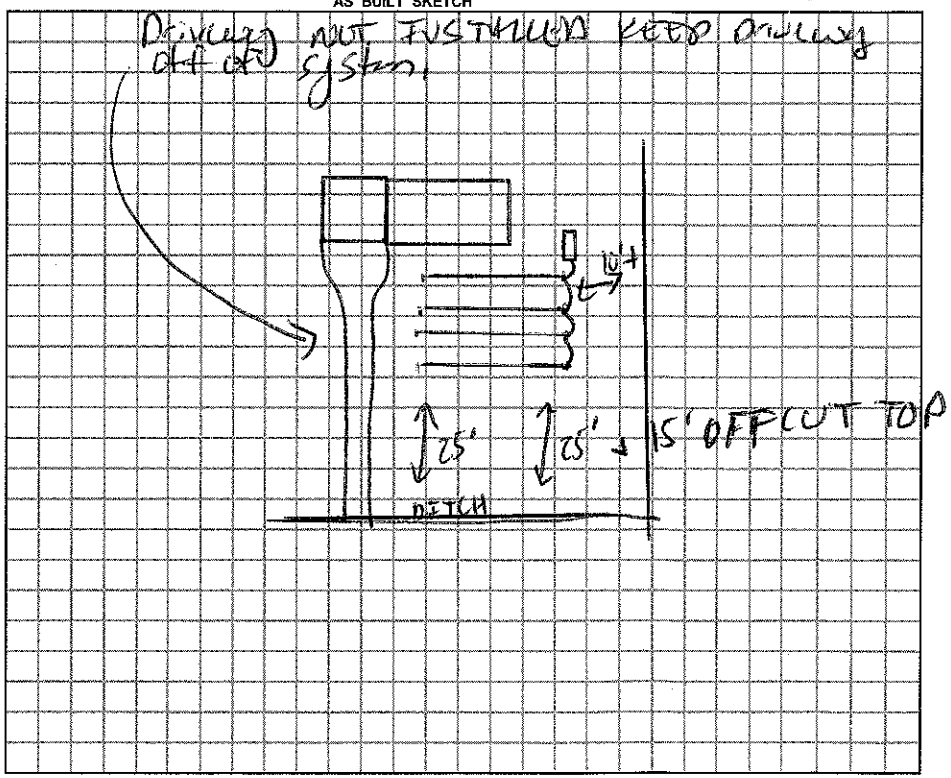


*Permit can be suspended or revoked if any false information is supplied toward securing the permit / any unauthorized changes are made to the site / any unauthorized changes are made in the installation of the system.*

☐ *IMPROVEMENT PERMIT w / plat valid without expiration.* ☒ *IMPROVEMENT PERMIT w / site plan valid for 60 mos.* ☒ *AUTHORIZATION TO CONSTRUCT valid for period equal to IMPROVEMENT PERMIT-not to exceed 60 mo.*

Owner / Applicant Signature: Date 4-30-09

Improvement Permit by: Date 4-30-09

Authorization to Construct by: Date 4-30-09

Installed by: Craig Boggs Grading

Operation Permit by: Date: 7-22-09

Existing System Inspected by: Date:

***YOU SHOULD CONTACT A LOCATOR SERVICE PRIOR TO ANY EXCAVATION.***

WHITE COPY Environmental Health YELLOW COPY (Final) Owner / Applicant PINK COPY (Initial) Owner / Applicant