12:00

IREDELL COUNTY HEALTH DEPARTMENT

STATESVILLE 704-878-5305 MOORESVILLE 704-664-5281

IMPROVEMENT PERMIT / AUTHORIZATION TO CONSTRUCT / OPERATION PERMIT / EXISTING SYSTEM INSPECTION

PERMIT# 140647 PIN# 4747-64-7616 DATE 3-7-07

OWNER OR APPLICANT JFI CUSTOM HOMES PHONE: Business 704-902-2772 Home 704-873-2530

ADDRESS 143 OAK GROVE ROAD, STATESVILLE, NC 28677

LOCATION WHITE'S FARM ROAD TO DONSDALE DRIVE, LOT AT END ON LEFT.

SUBDIVISION DONSDALE BLOCK / SECTION 2 LOT 41 LOT AREA 0.554 ACRE SITE CLASS. PS DESIGN FLOW 360 L.T.A.R. 0.30 GAL/FT²

Septic Tank: 1000 Gallons; STB 1012 Date 11-6-06
Pump Tank: _____ Gallons; PT _____ Date _____
Pump Make: _____ Model _____ Serial No. _____
Nitrification Field: No Fields 1 Square Feet EQ TO 1200 Linear Feet 300
No Lines THREE Trench Width 36" Max Trench Bottom Depth 36" Gravel Depth N/A

☑ New System ☐ Repair ☐ Expansion System Type: I II III IV V VI
System Description: 25% REDUCTION GRAVITY
Repair System Description: 25% REDUCTION, GRAVITY
Maintenance Agreement Required: ☐ Yes ☑ No

☑ House/Mod. Home ☐ Mobile Home ☐ Business ☐ Other
No. Bedrooms 3 No. Persons ____ No. Employees ____


Water Supply: ☐ Individual ☑ Public ☐ Community

☐ Gravity ☐ Pressure ☐ Slab ☑ Crawl Space ☐ Basement w/plumbing ☐ Basement wo/plumbing

Comments:/Conditions: INSTALL 25% REDUCTION SYSTEM AS FLAGGED

Comments:/Conditions: Septic tank Mark Yellow top-Lite

INITIAL SITE SKETCH

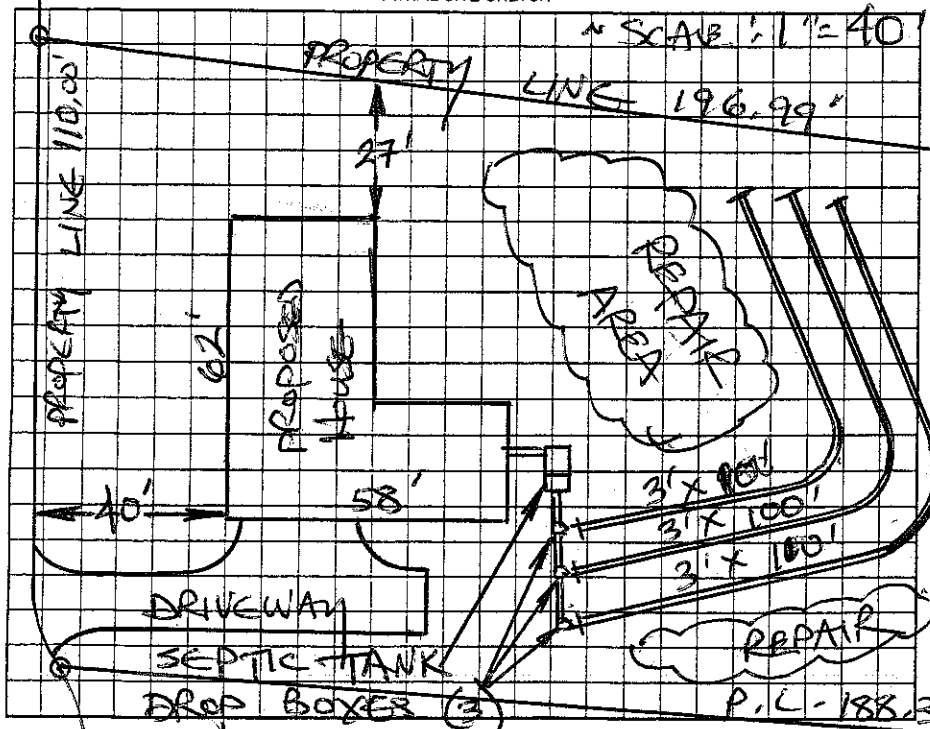

AS BUILT SKETCH

Landscape disturbance

DONSDALE DRIVE

CHC-DE-SAC

Permit can be suspended or revoked if any false information is supplied toward securing the permit/any unauthorized changes are made to the site/any unauthorized changes are made in the installation of the system. Improvement Permit with plat valid without expiration ☐ Improvement Permit with site plan valid for sixty months ☑ Authorization to Construct is valid for a period equal to that of Improvement Permit – not to exceed sixty months.

Signed: _____ date 3-7-07 Installed by: Craig Thompson

Improvement Permit by: STEVE HEDRICK date 3-7-07 Operation Permit by: _____ date 2 May 07

Authorization to Construct by: STEVE HEDRICK date 3-7-07 Existing System Inspection by: _____ date _____

HEALTH DEPT. COPY: WHITE OWNER COPY (FINAL): YELLOW OWNER COPY (INITIAL): PINK