IREDELL COUNTY HEALTH DEPARTMENT

STATESVILLE 704-878-5305 MOORESVILLE 704-664-5281

IMPROVEMENT PERMIT / AUTHORIZATION TO CONSTRUCT / OPERATION PERMIT / EXISTING SYSTEM INSPECTION

PERMIT# 148825 PIN# 4747647876 DATE 3-28-08

OWNER OR APPLICANT Tom Palmer Homes, Inc. PHONE: Business 980-241-9693 Home 704-500-2164

ADDRESS 130 Houpe Ridge

LOCATION Whites Farm Rd, (R) Donsdale, (L) Houpe Ridge

SUBDIVISION Donsdale BLOCK / SECTION 2 LOT 37 LOT AREA .676 SITE CLASS. PS DESIGN FLOW 360 L.T.A.R. .3

Septic Tank: 1000 Gallons: STB 872 Date 5-9-08

Pump Tank: _____ Gallons: PT _____ Date _____

Pump Make: _____ Model _____ Serial No. _____

Nitrification Field: No Fields 1 Square Feet 1200 Linear Feet 300

No Lines 3 Trench Width 36" Max Trench Bottom Depth 36" Gravel Depth _____

☒ New System ☐ Repair ☐ Expansion System Type: I II III IV V VI

System Description: 25% Reduction Gravity

Repair System Description: 50% Reduction LPP

Maintenance Agreement Required: ☐ Yes ☒ No

☒ House/Mod. Home ☐ Mobile Home ☐ Business ☐ Other

No. Bedrooms 3 No. Persons _____ No. Employees _____

Water Supply: ☒ Individual ☐ Public ☐ Community

☐ Gravity ☐ Pressure ☐ Slab ☒ Crawl Space ☐ Basement w/plumbing ☐ Basement wo/plumbing


Comments:/Conditions:

(3) 3" x 100' lines

Comments:/Conditions:

Septic Marker Red Top Later

INITIAL SITE SKETCH

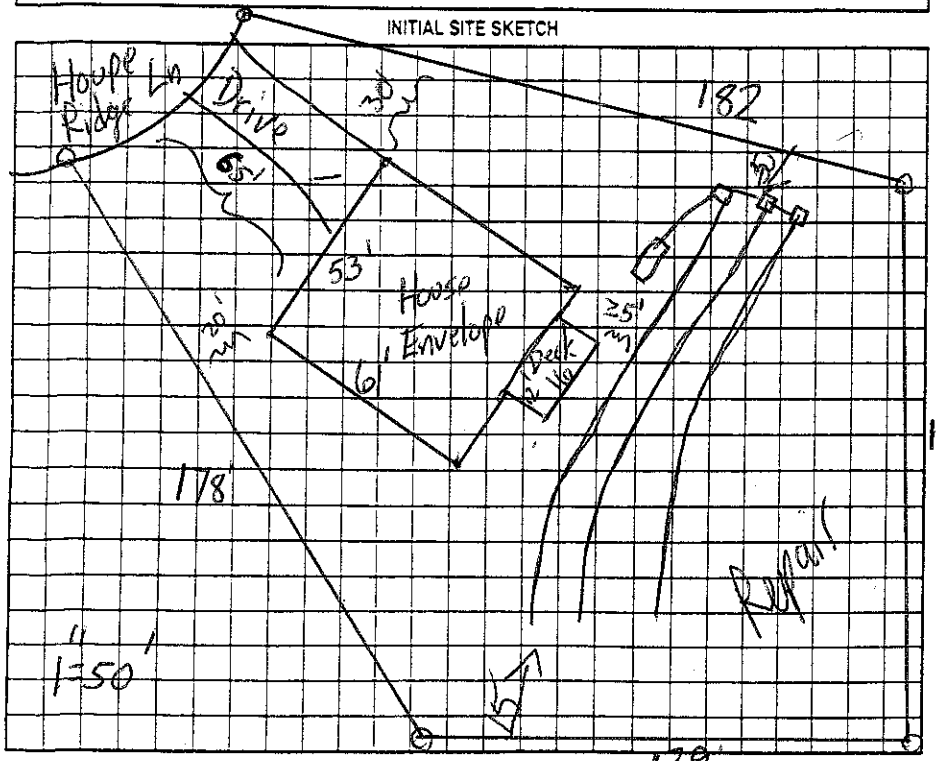

AS BUILT SKETCH

Permit can be suspended or revoked if any false information is supplied toward securing the permit/any unauthorized changes are made to the site/any unauthorized changes are made in the installation of the system. Improvement Permit with plat valid without expiration ☐ Improvement Permit with site plan valid for sixty months ☒ Authorization to Construct is valid for a period equal to that of Improvement Permit – not to exceed sixty months.

Signed: Tom Palmer date 4-4-08

Improvement Permit by: _____ date 3-28-08

Authorization to Construct by: _____ date 3-28-08

Installed by: _____

Operation Permit by: _____ date 7-29-08

Existing System Inspection by: _____ date _____

HEALTH DEPT. COPY: WHITE OWNER COPY (FINAL): YELLOW OWNER COPY (INITIAL): PINK