IREDELL COUNTY HEALTH DEPARTMENT

STATESVILLE 704-878-5305 MOORESVILLE 704-664-5281

IMPROVEMENT PERMIT / AUTHORIZATION TO CONSTRUCT / OPERATION PERMIT / EXISTING SYSTEM INSPECTION

PERMIT# 123336 PIN# 4747-65-0548 DATE 9/27/04

OWNER OR CONTRACTOR Elston Homes PHONE: Business (704) 902-0162 Home

ADDRESS P.O. Box 423 Statesville N.C. 28687

LOCATION Hwy 21 N, (L) Shumaker Drive turns into Whites Farm Rd, (R) Donsdale Drive to 11th lot on Left

SUBDIVISION Donsdale BLOCK / SECTION I LOT 11 LOT AREA .726 Ac SITE CLASS PS DESIGN FLOW 360 L.T.A.R. .30

Septic Tank: 1,000 Gallons; STB 1012 Date 2-2-05
Pump Tank: Gallons; PT Date
Pump Make: Model Serial No.
Nitrification Field: No Fields 1 Square Feet 1,200 Linear Feet 400
No Lines 4 Trench Width 36" Max Trench Bottom Depth 36" Gravel Depth 12"

☒ New System ☐ Repair System Type: I, II, III, IV, V, VI
System Description: Conventional / Gravity
Repair System Description: 50% Reduction Gravity
Maintenance Agreement Required: ☐ Yes ☒ No


☒ House/Mod. Home No. Bedrooms 3
☐ Mobile Home No. Bathrooms
☐ Business No. Employees
☐ Other
☐ Slab ☒ Crawl Space ☐ Basement w/plumbing ☐ Basement wo/plumbing

Water Supply: ☐ Individual ☒ Public ☐ Community


Comments:/Conditions: ① Install liner on contour ② Do not install when wet

Comments:/Conditions: TUFFTITE FILLER + MARKER
BUILDER SHOWED INSTALLER P/L covered
INSTALLER SHOWED ME LC 10' OFF +

INITIAL SITE SKETCH

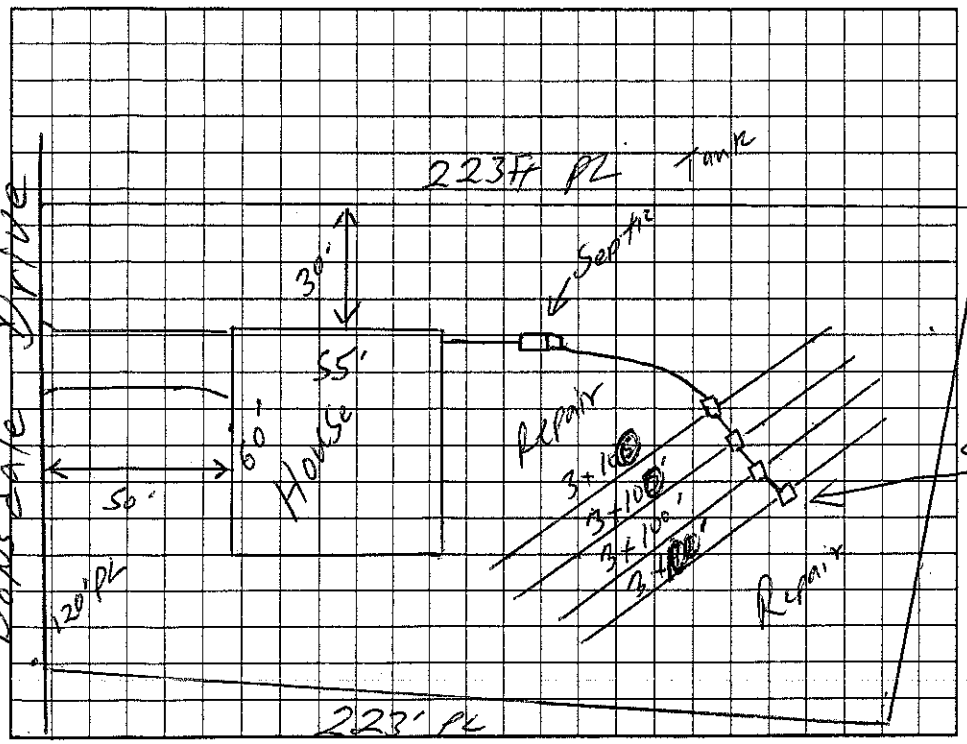

AS BUILT SKETCH

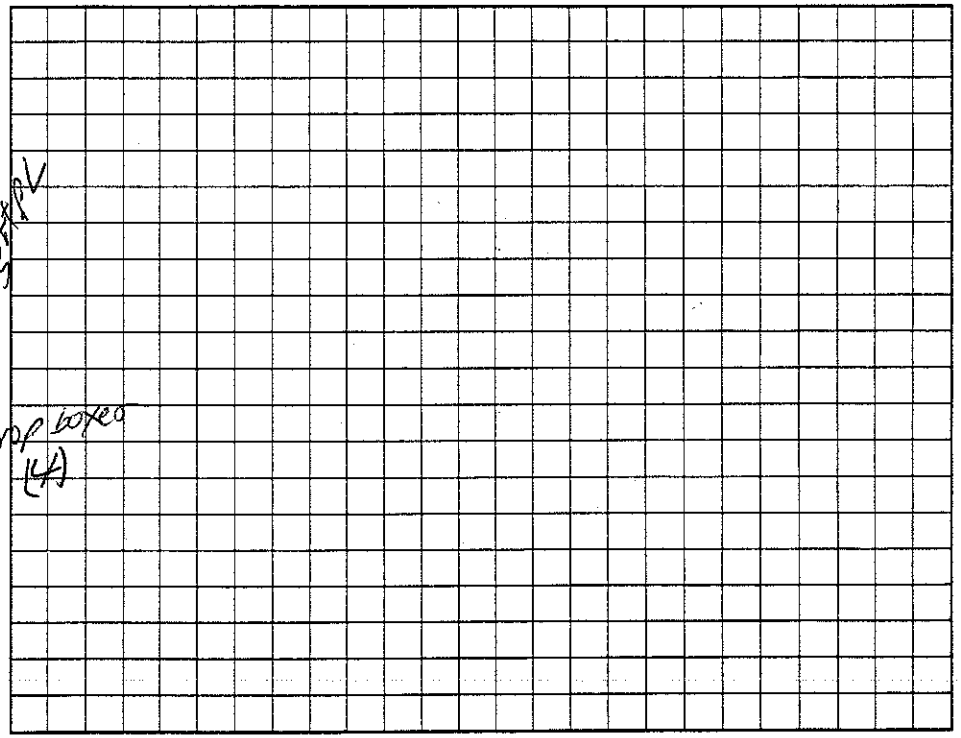

Permit can be suspended or revoked if any false information is supplied toward securing the permit/any unauthorized changes are made to the site/any unauthorized changes are made in the installation of the system. Improvement Permit with plat valid without expiration. Improvement Permit with site plan valid for sixty months. Authorization to Construct is valid for a period equal to that of Improvement Permit – not to exceed sixty months.

Signed: date 10-08-04 Installed by: CRAIG THOMPSON

Improvement Permit by: William O. Johnson date 9/27/04 Operation Permit by: date 8-16-05

Authorization to Construct by: William O. Johnson date 9/27/04 Existing System Inspection by: date

HEALTH DEPT. COPY: WHITE OWNER COPY (FINAL): YELLOW OWNER COPY (INITIAL): PINK