IREDELL COUNTY HEALTH DEPARTMENT

STATESVILLE 704-878-5305 MOORESVILLE 704-664-5281

IMPROVEMENT PERMIT / AUTHORIZATION TO CONSTRUCT / OPERATION PERMIT / EXISTING SYSTEM INSPECTION

DATE 6-27-08

PERMIT# 150859 PIN# 4747651095

OWNER OR APPLICANT JFJ Custom Homes PHONE: Business 704 873 2530 Home

ADDRESS 129 Stallion Lane

LOCATION Jennys Rd, (L) on White Farm (L) on Donsdale, (L) on Stallion, 5th lot on (R)

SUBDIVISION Donsdale BLOCK / SECTION 2 LOT 22 LOT AREA .54 SITE CLASS PS DESIGN FLOW 360 L.T.A.R. .3

Septic Tank: 1000 Gallons; STB 1012 Date 1-15-07

Pump Tank: Gallons; PT Date

Pump Make: Model Serial No.

Nitrification Field: No Fields 1 Square Feet 1200 Linear Feet 300

No Lines 4 Trench Width 36" Max Trench Bottom Depth 36"

■ New System ☐ Repair ☐ Expansion System Type: I (II) III IV V VI

System Description: 25% Reduction Gravity

Repair System Description: 25% Reduction Gravity

Maintenance Agreement Required: ☐ Yes ■ No

Gravel Depth ■ Gravity ☐ Pressure

■ House/Mod. Home No. Bedrooms 3

☐ Mobile Home No. Persons

☐ Business No. Employees

☐ Other

Water Supply: ☐ Individual ■ Public ☐ Community


☐ Slab ■ Crawl Space ☐ Basement w/plumbing ☐ Basement wo/plumbing

Comments:/Conditions:

Comments:/Conditions:

- System installed according to initial site sketch
- yellow tuf tite filter installed
- septic tank marker installed

INITIAL SITE SKETCH 1"=50'

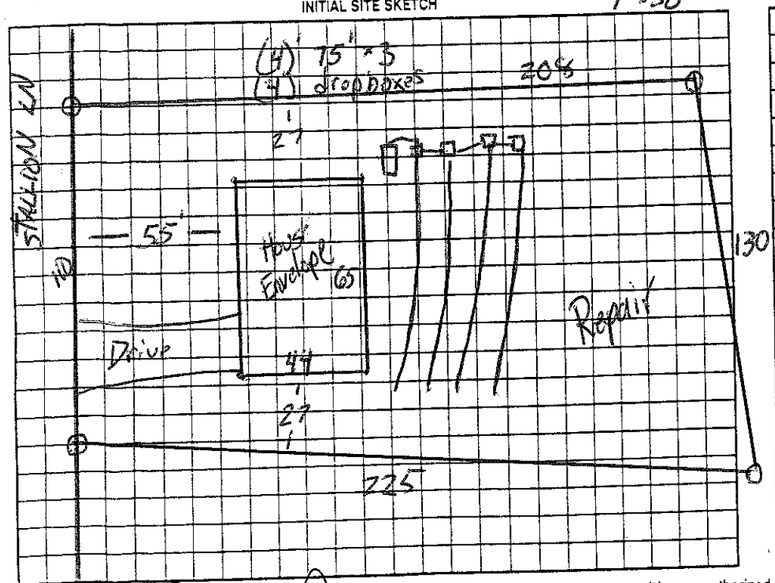

AS BUILT SKETCH

Permit can be suspended or revoked if any false information is supplied toward securing the permit/any unauthorized changes are made to the site/any unauthorized changes are made in the installation of the system. Improvement Permit with plat valid without expiration ☐ Improvement Permit with site plan valid for sixty months ☒ Authorization to Construct is valid for a period equal to that of Improvement Permit – not to exceed sixty months.

Signed: date 6-27-08

Improvement Permit by: date 6-27-08

Authorization to Construct by: date 6-27-08

Installed by: Craig Thompson

Operation Permit by: Kelly Cook date 8-8-08

Existing System Inspection by: date

HEALTH DEPT. COPY: WHITE OWNER COPY (FINAL): YELLOW OWNER COPY (INITIAL): PINK