IREDELL COUNTY HEALTH DEPARTMENT

STATESVILLE 704-878-5305 (CT) MOORESVILLE 704-664-5281

IMPROVEMENT PERMIT / AUTHORIZATION TO CONSTRUCT / OPERATION PERMIT / EXISTING SYSTEM INSPECTION

PERMIT# 142727 PIN# 4797652185 DATE 6-5-07

OWNER OR APPLICANT Janice Sharpe McAlpin PHONE: Business 704 876 4928 Home

ADDRESS 134 Stallion Lane

LOCATION 21 N (L) Shoemaker Dr. (R) to Dogsdale Dr. (L) on Stallion

SUBDIVISION Dogsdale BLOCK / SECTION 2 LOT 21 LOT AREA .649 SITE CLASS. PS DESIGN FLOW 360 L.T.A.R. .3

Septic Tank: 1000 Gallons; STB 1000 Date 9-15-07
Pump Tank: ____ Gallons; PT ____ Date ____
Pump Make: ____ Model ____ Serial No. ____
Nitrification Field: No Fields 1 Square Feet 1200 Linear Feet 300
No Lines ____ Trench Width ____ Max Trench Bottom Depth ____ Gravel Depth ____ ☐ Gravity ☐ Pressure

☑ New System ☐ Repair ☐ Expansion System Type: I (II) III IV V VI
System Description: 25% Reduction Gravity
Repair System Description: 25% Reduction Gravity
Maintenance Agreement Required: ☐ Yes ☐ No

☐ House/Mod. Home ☐ Mobile Home ☐ Business ☐ Other
No. Bedrooms ____ No. Persons ____ No. Employees ____


Water Supply: ☐ Individual ☐ Public ☐ Community

☐ Slab ☐ Crawl Space ☐ Basement w/plumbing ☐ Basement wo/plumbing

Comments:/Conditions:

Comments:/Conditions:
Brown Filter

INITIAL SITE SKETCH

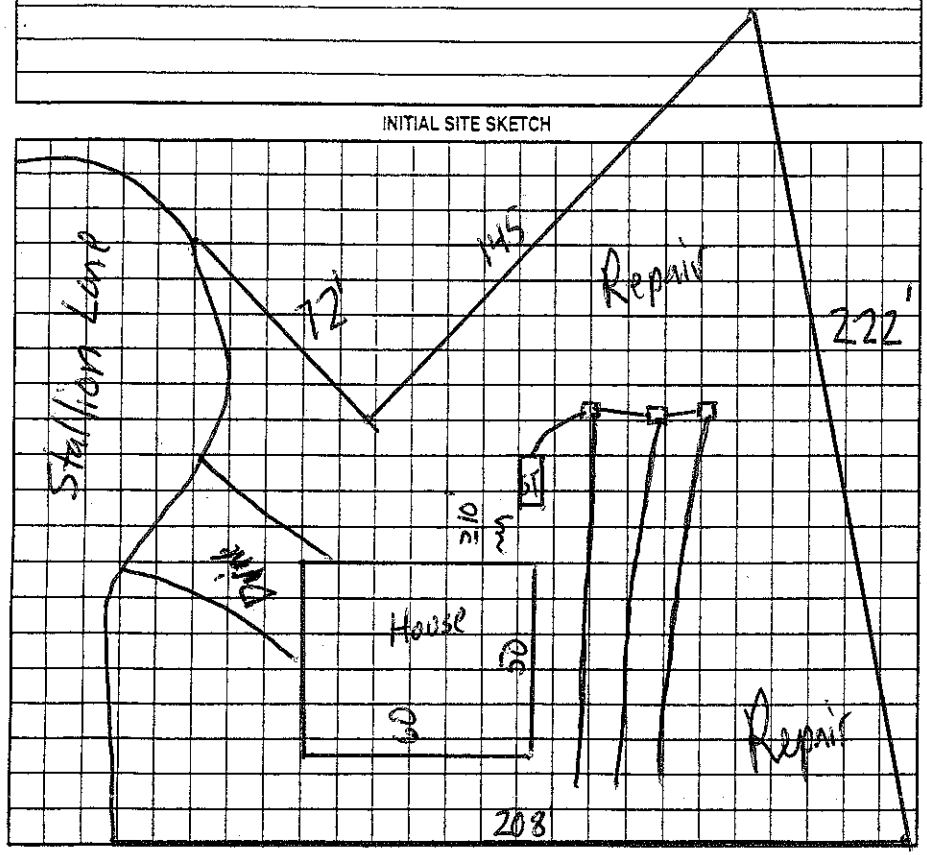

AS BUILT SKETCH

Permit can be suspended or revoked if any false information is supplied toward securing the permit/any unauthorized changes are made to the site/any unauthorized changes are made in the installation of the system. Improvement Permit with plat valid without expiration ☐ Improvement Permit with site plan valid for sixty months ☐ Authorization to Construct is valid for a period equal to that of Improvement Permit – not to exceed sixty months.

Signed: Jan McAlpin date 6/11/07
Improvement Permit by: [signature] date 6-5-07
Authorization to Construct by: [signature] date 6-5-07

Installed by: KB Mason
Operation Permit by: [signature] date 11/13/07
Existing System Inspection by: ____ date ____

HEALTH DEPT. COPY: WHITE OWNER COPY (FINAL): YELLOW OWNER COPY (INITIAL): PINK