IREDELL COUNTY HEALTH DEPARTMENT

STATESVILLE 704-878-5305 (CI) MOORESVILLE 704-664-5281

IMPROVEMENT PERMIT / AUTHORIZATION TO CONSTRUCT / OPERATION PERMIT / EXISTING SYSTEM INSPECTION

PERMIT# 14244520 PIN# 4747654025 DATE 6-5-07

OWNER OR APPLICANT JEJ Custom Homes PHONE: Business 704 902 2772 Home 704 873-2530

ADDRESS 121 Houpe Ridge Ln.

LOCATION 21 N (L) on Shumaker (R) on Donsdale (L) on Houpe Ridge Ln.

SUBDIVISION (2) Donsdale BLOCK / SECTION 2 LOT 33 LOT AREA .609 SITE CLASS. PS I DESIGN FLOW 360 L.T.A.R. .3

Septic Tank: 1000 Gallons; STB 1017 Date 3-19-07
Pump Tank: ____ Gallons; PT ____ Date ____
Pump Make: ____ Model ____ Serial No. ____
Nitrification Field: No Fields 1 Square Feet 1200 Linear Feet 300
No Lines 4 Trench Width 36" Max Trench Bottom Depth 36" Gravel Depth ____

☒ New System ☐ Repair ☐ Expansion System Type: I (II) III IV V VI
System Description: 25% Reduction - Gravity
Repair System Description: 25% Reduction - Gravity
Maintenance Agreement Required: ☐ Yes ☒ No

☒ House/Mod. Home ☐ Mobile Home ☐ Business ☐ Other
No. Bedrooms 3 No. Persons ____ No. Employees ____


Water Supply: ☒ Individual ☒ Public ☐ Community

☒ Gravity ☐ Pressure ☐ Slab ☒ Crawl Space ☐ Basement w/plumbing ☐ Basement wo/plumbing


Comments/Conditions:

Comments/Conditions:
Yellow

INITIAL SITE SKETCH

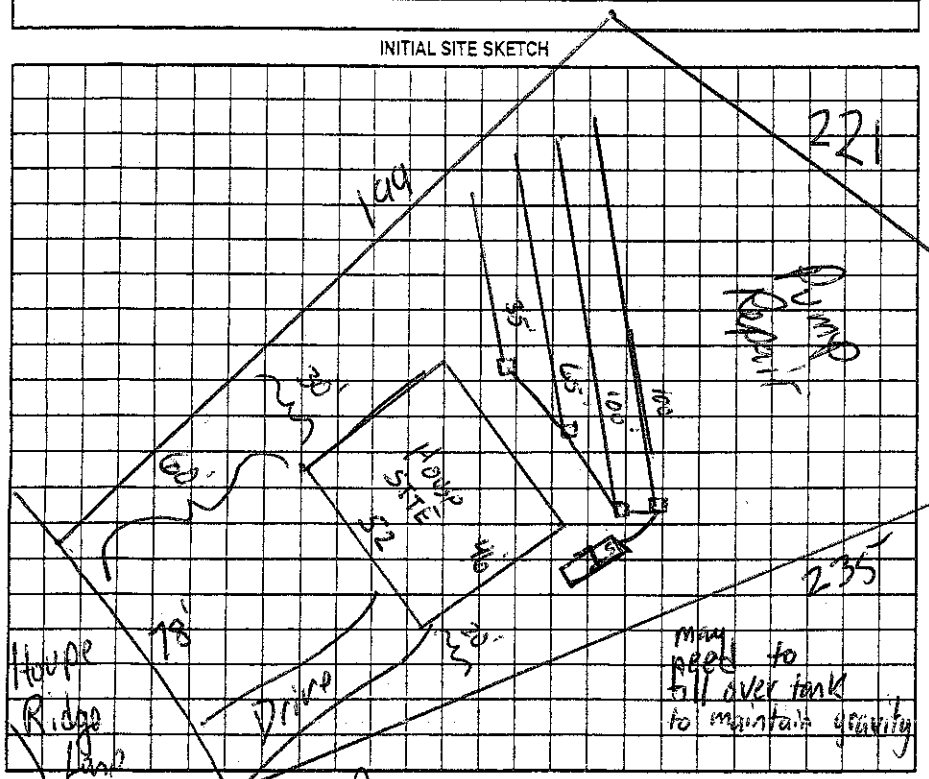

AS BUILT SKETCH

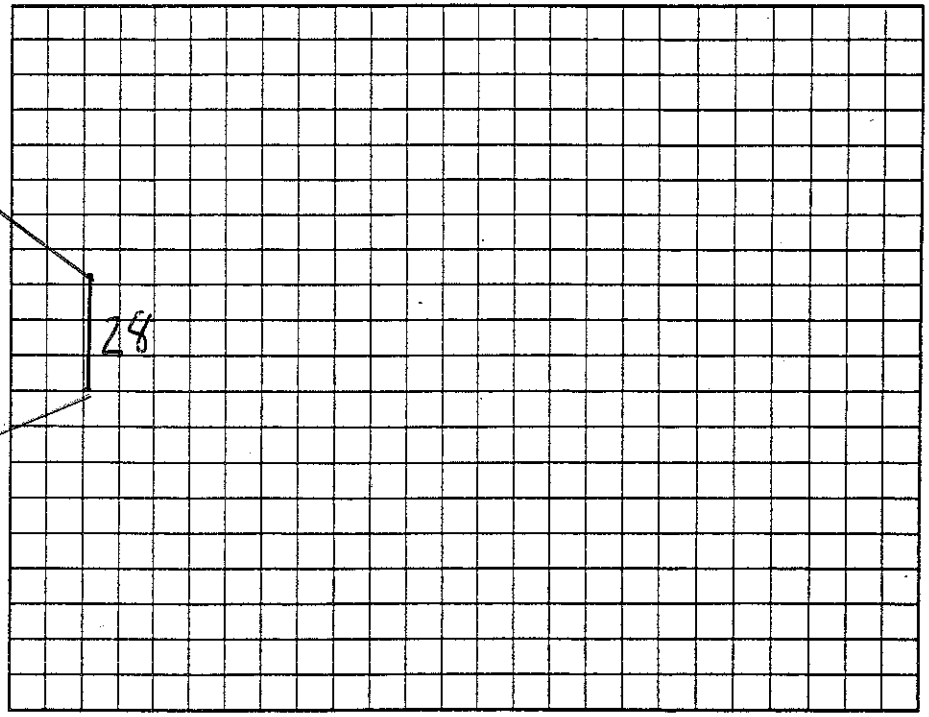

Permit can be suspended or revoked if any false information is supplied toward securing the permit/any unauthorized changes are made to the site/any unauthorized changes are made in the installation of the system. Improvement Permit with plat valid without expiration ☐ Improvement Permit with site plan valid for sixty months ☒ Authorization to Construct is valid for a period equal to that of Improvement Permit – not to exceed sixty months.

Signed: [signature] date 6-5-07

Improvement Permit by: [signature] date 6-5-07

Authorization to Construct by: [signature] date 6-5-07

Installed by: Craig Thompson

Operation Permit by: [signature] date 9-28-07

Existing System Inspection by: ____ date ____

HEALTH DEPT. COPY: WHITE OWNER COPY (FINAL): YELLOW OWNER COPY (INITIAL): PINK