IREDELL COUNTY HEALTH DEPARTMENT

STATESVILLE 704-878-5305 MOORESVILLE 704-664-5281

IMPROVEMENT PERMIT / AUTHORIZATION TO CONSTRUCT / OPERATION PERMIT / EXISTING SYSTEM INSPECTION

PERMIT# 72593 PIN# DATE 4-2-98

OWNER OR CONTRACTOR Lisa Estrada PHONE: Business 539-4608 Home

ADDRESS 152 Taurus Ln Sta

LOCATION 21 N TL Jennings Th Taurus 2nd mbt Rt

SUBDIVISION BLOCK / SECTION LOT LOT AREA Acre SITE CLASS. PS DESIGN FLOW 480 L.T.A.R. .3

Septic Tank: EX 1000 Gallons; STB Date

Pump Tank: Gallons; PT Date

Pump Make: Model Serial No.

Add'n Nitrification Field: No Fields Square Feet 300 Linear Feet 133

No Lines 1 Trench Width 36" Max Trench Bottom Depth 36" Gravel Depth 12"

☑ New System ☐ Repair System Type: I, II, III, IV, V, VI

System Description: Conv. Gravity

Repair System Description:

Maintenance Agreement Required: ☐ Yes ☐ No

☐ House/Mod. Home No. Bedrooms

☐ Mobile Home No. Bathrooms

☐ Business No. Employees

☐ Other


☐ Slab ☐ Crawl Space ☐ Basement w/plumbing ☐ Basement wo/plumbing

Water Supply: ☐ Individual ☐ Public ☐ Community


Comments:/Conditions:

Adding 1 Bedroom To Prior 3 bedroom Home

INITIAL SITE SKETCH

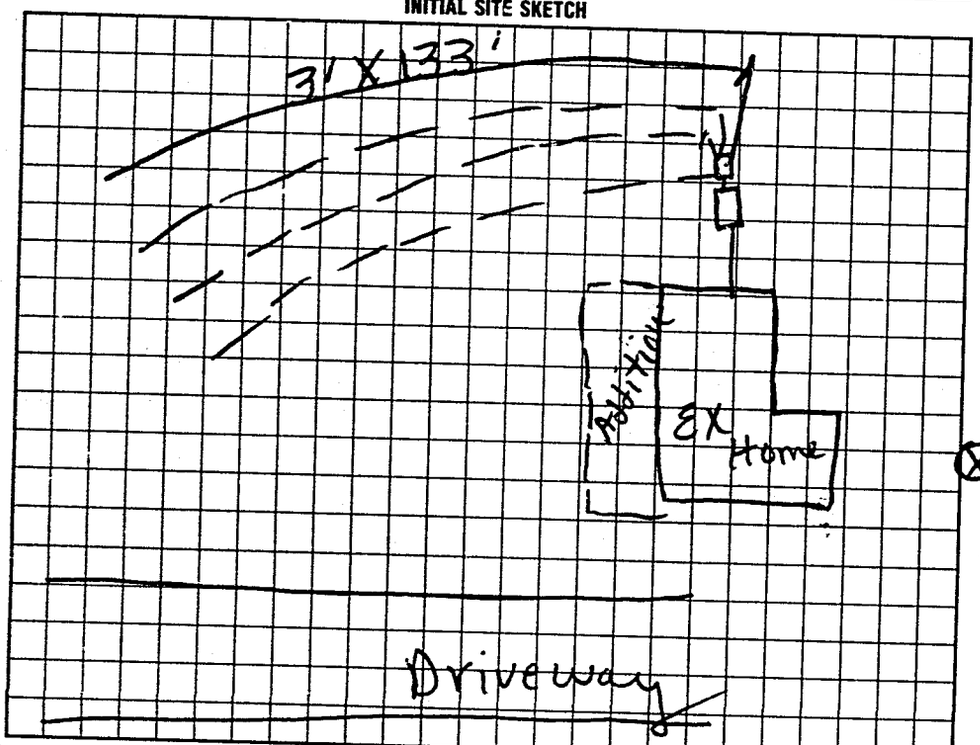

AS BUILT SKETCH

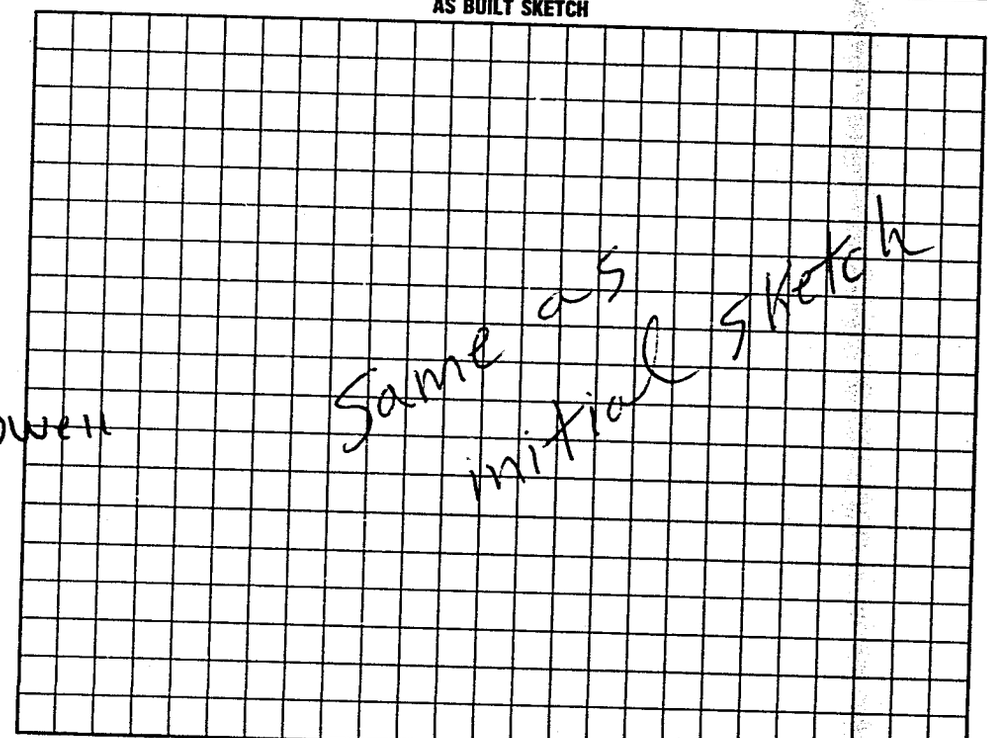

I understand that this permit can be suspended or revoked if any false information is supplied toward securing the permit/any unauthorized changes are made to the site/any unauthorized changes are made in the installation of the system. Improvement Permit with plat valid without expiration. Improvement Permit with site plan valid for sixty months. Authorization to Construct is valid for a period equal to that of Improvement Permit – not to exceed sixty months.

Signed: [signature] date 4-6-98 Installed by: Kenny Matison

Improvement Permit by: P.C. Moore date 4-2-98 Operation Permit by: P.C. Moore date 10-20-95

Authorization to Construct by: P.C. Moore date 4-2-98 Existing System Inspection by: date

HEALTH DEPT COPY WHITE INSPECTION COPY (FINAL) GREEN OWNER COPY (FINAL) YELLOW INSPECTION COPY (INITIAL): PINK OWNER COPY (INITIAL): GOLD