Belk Construction / Christopher Palumbo

IREDELL COUNTY HEALTH DEPARTMENT

Statesville Office (704) 878-5305 Mooresville Office (704) 660-3625 PERMIT # 219401

IMPROVEMENT PERMIT / AUTHORIZATION TO CONSTRUCT / OPERATION PERMIT / EXISTING SYSTEM

PIN # 4747660451

APPLICANT: Nicle Belk APPLICANT ADDRESS: 358 Montibello Dr Mooresville NC 28117

SITE ADDRESS: 137 Donsdale Dr Statesville NC PHONE: 704-507-6327 ALT. PHONE: N/A


SITE DIRECTIONS: 77 N T/L Hwy 21 T/L Jennings Rd T/L Whites Farm Rd T/L Donsdale Lot on left

SUBDIVISION: Donsdale SECTION: P1 LOT # 4 LOT AREA: .829 ac DESIGN FLOW: 360 L.T.A.R.: 0.3


Septic Tank	1000 (gal)	STB	Tee	Date	4/16	[X] New System [ ] Repair [ ] Expansion	System Type: I II III IV V VI	[X] Residence	No. Bedrooms	3	Water Supply
Pump Tank	(gal)	PT		Date		System Description:	25% Reduction	[ ] Business	No. Persons	6	[ ] Private
Pump Make		Model		Serial #		Repair System Description:	Pump 25% Reduction	[ ] Other	No. Employees		[X] Public
# Nitrification Fields	1	# Lines	4	Linear Ft:	300	Maintenance Agreement Required:	[ ] YES [X] NO	[X] Slab	[ ] Crawl Space		[ ] Community
Trench Width	36"	Max. Trench Bottom Depth	36"	Gravel Depth	N/A	[X] GRAVITY	[ ] PRESSURE	[ ] Basement w/plumbing			[ ] Basement w/o plumbing

Comments / Conditions: Install 25% reduction on Contour with serial distribution

INITIAL SITE SKETCH

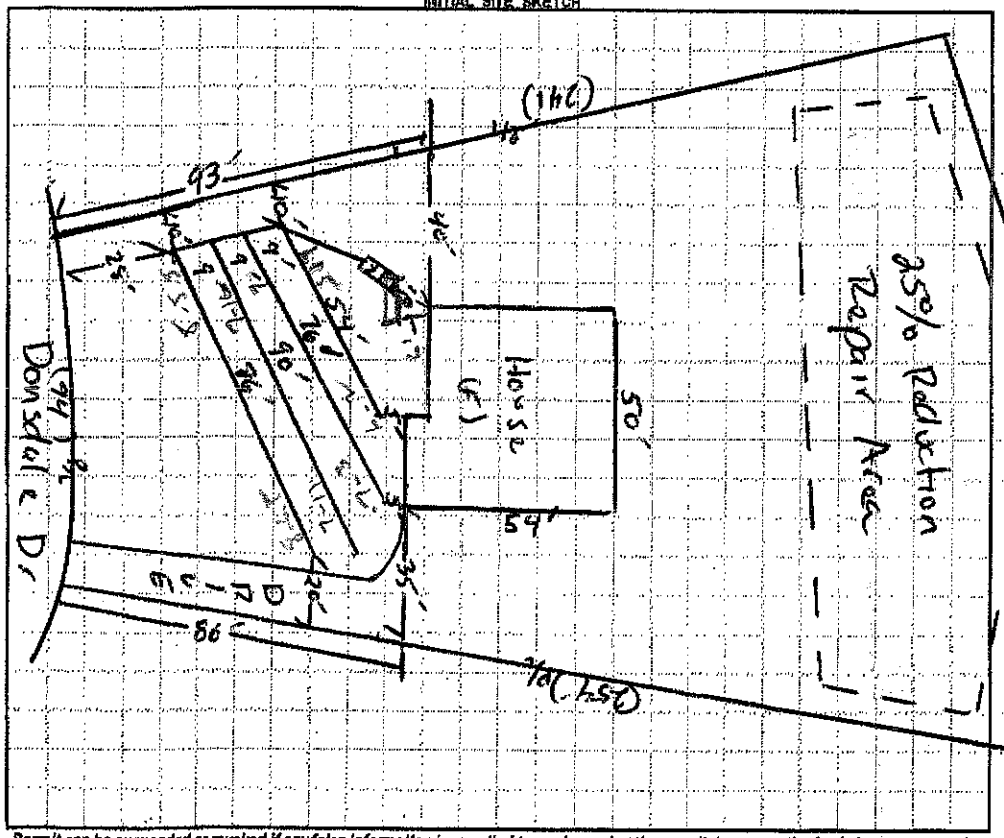

AS BUILT SKETCH

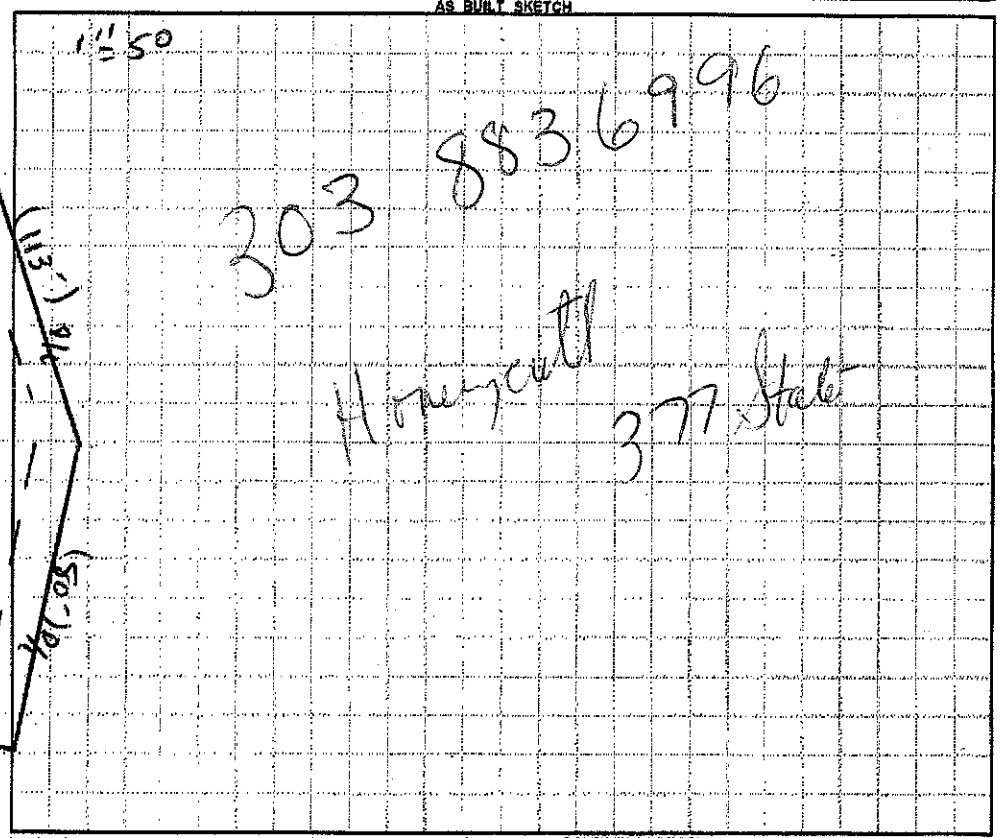

Permit can be suspended or revoked if any false information is supplied toward securing the permit / any unauthorized changes are made to the site / any unauthorized changes are made in the installation of the system. **CONTACT A LOCATOR SERVICE PRIOR TO ANY EXCAVATION**

[ ] **IMPROVEMENT PERMIT** *with plat valid without expiration.* [X] **IMPROVEMENT PERMIT** *with site plan valid for 60 mos.* [X] **AUTHORIZATION TO CONSTRUCT** *valid for period equal to IMPROVEMENT PERMIT--not to exceed 60 mo.*

Owner / Applicant Signature: Pink never signed for or picked up! Date: Installed by: Al Backhoe

IMPROVEMENT PERMIT by: Date: 07/27/16 OPERATION PERMIT by: Date: 11/10/16

AUTHORIZATION TO CONSTRUCT by: Date: 07/27/16 Existing System Inspected by: Date:

Health Dept. Copy - WHITE Applicant (Final Approval) - YELLOW Applicant (Conditional Approval) - PINK