IREDELL COUNTY HEALTH DEPARTMENT

STATESVILLE 704-878-5305 (A) MOORESVILLE 704-664-5281

IMPROVEMENT PERMIT / AUTHORIZATION TO CONSTRUCT / OPERATION PERMIT / EXISTING SYSTEM INSPECTION

PERMIT# 121583 PIN# 4947-66-2035 DATE 7/8/04

OWNER OR CONTRACTOR Michael L. Lewis PHONE: Business (704) 902-6866 Home (704) 873-9180

ADDRESS P.O Box 1717 Statesville, N.C. 28687

LOCATION 2 N. (2) White Farm Rd, (R) on Dansdale Drive 1st, 7th lot on left

SUBDIVISION Dansdale BLOCK / SECTION I LOT 7 LOT AREA .70 Acres SITE CLASS. PS DESIGN FLOW 360 L.T.A.R. .30 gpd/ft²

Septic Tank: 1,000 Gallons; STB 1007 Date 4-4-05
Pump Tank: _____ Gallons; PT _____ Date _____
Pump Make: _____ Model _____ Serial No. _____
Nitrification Field: No Fields 1 Square Feet 1200 Linear Feet 400
No Lines 6 Trench Width 36" Max Trench Bottom Depth 30" Gravel Depth 12"

☒ New System ☐ Repair System Type: I, II, III, IV, V, VI
System Description: Gravity, Conventional
Repair System Description: Pump, 25% Reduction
Maintenance Agreement Required: ☐ Yes ☐ No


☒ House/Mod. Home No. Bedrooms 3
☐ Mobile Home No. Bathrooms 2
☐ Business No. Employees _____
☐ Other _____
☐ Slab ☒ Crawl Space ☐ Basement w/plumbing ☐ Basement wo/plumbing

Water Supply:
☐ Individual
☒ Public
☐ Community

Comments:/Conditions: (1) Install lines on contour

Comments:/Conditions: SEPTIC TANK WITH MARKER INSTALLED ~~ACCESS~~ USING "2ABEL" FILTER

INITIAL SITE SKETCH (Not to Scale)

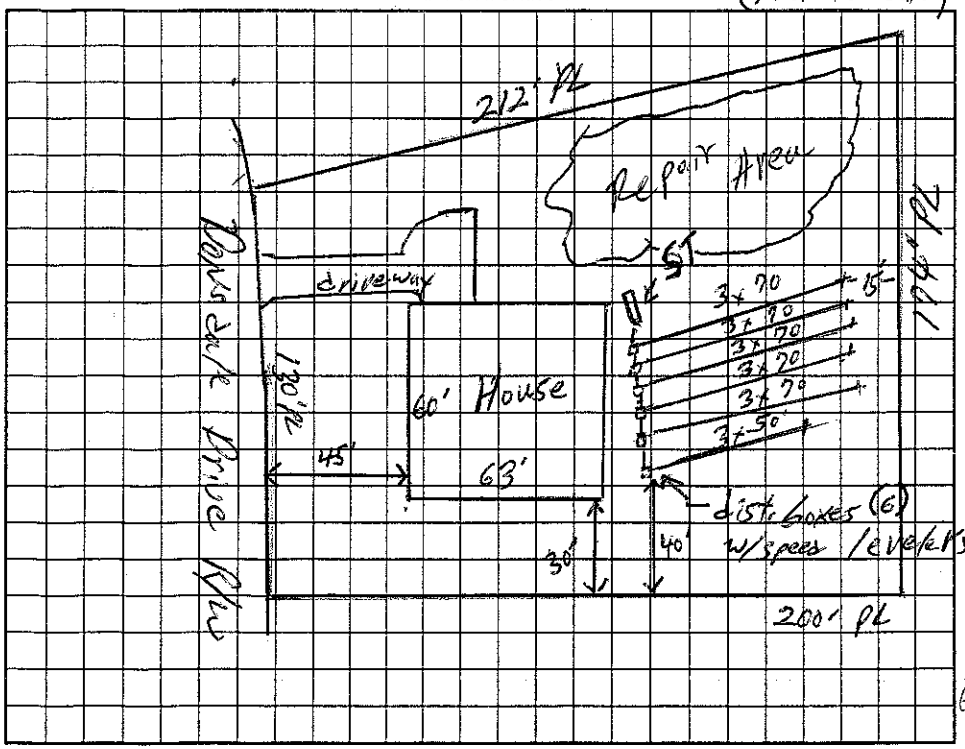

AS BUILT SKETCH

SYSTEM INSTALLED ACCORDING TO INITIAL SITE SKETCH

Permit can be suspended or revoked if any false information is supplied toward securing the permit/any unauthorized changes are made to the site/any unauthorized changes are made in the installation of the system. Improvement Permit with plat valid without expiration. Improvement Permit with site plan valid for sixty months. Authorization to Construct is valid for a period equal to that of Improvement Permit – not to exceed sixty months.

Signed: _____ date 7/8/04 Installed by: JAMES HUMBER

Improvement Permit by: William O. Johnson date 7/8/04 Operation Permit by: STEVE HENDRICK date 5-10-05

Authorization to Construct by: William O. Johnson date 7/8/04 Existing System Inspection by: _____ date _____

HEALTH DEPT. COPY: WHITE OWNER COPY (FINAL): YELLOW OWNER COPY (INITIAL): PINK